



烏城公園樹木位置図 全体図

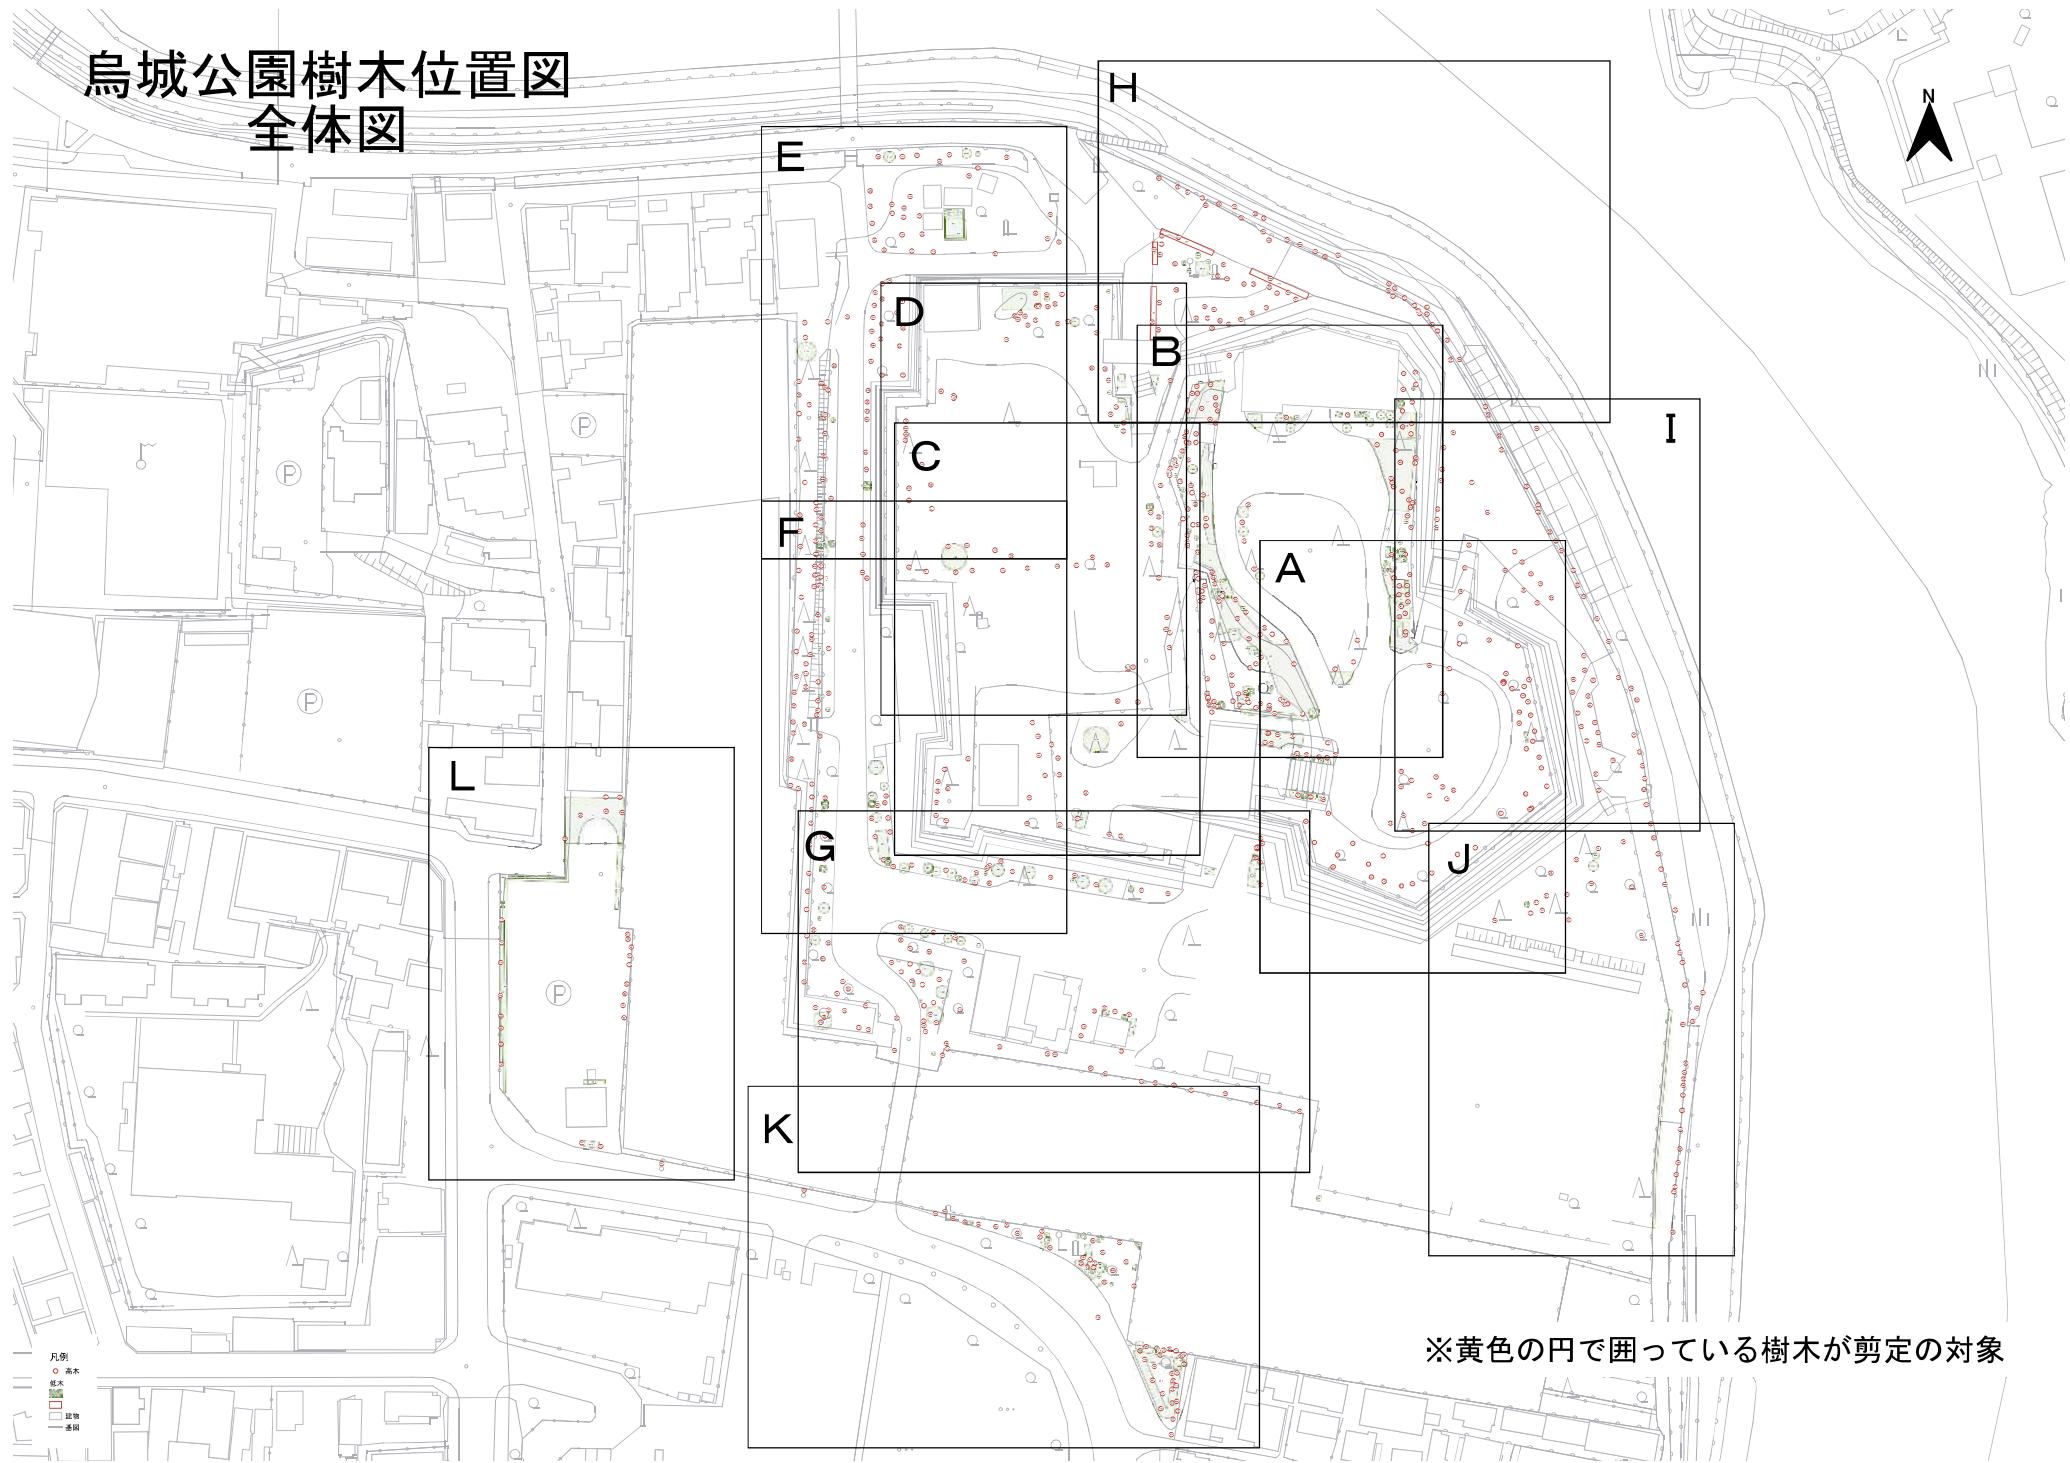



A S=250:1

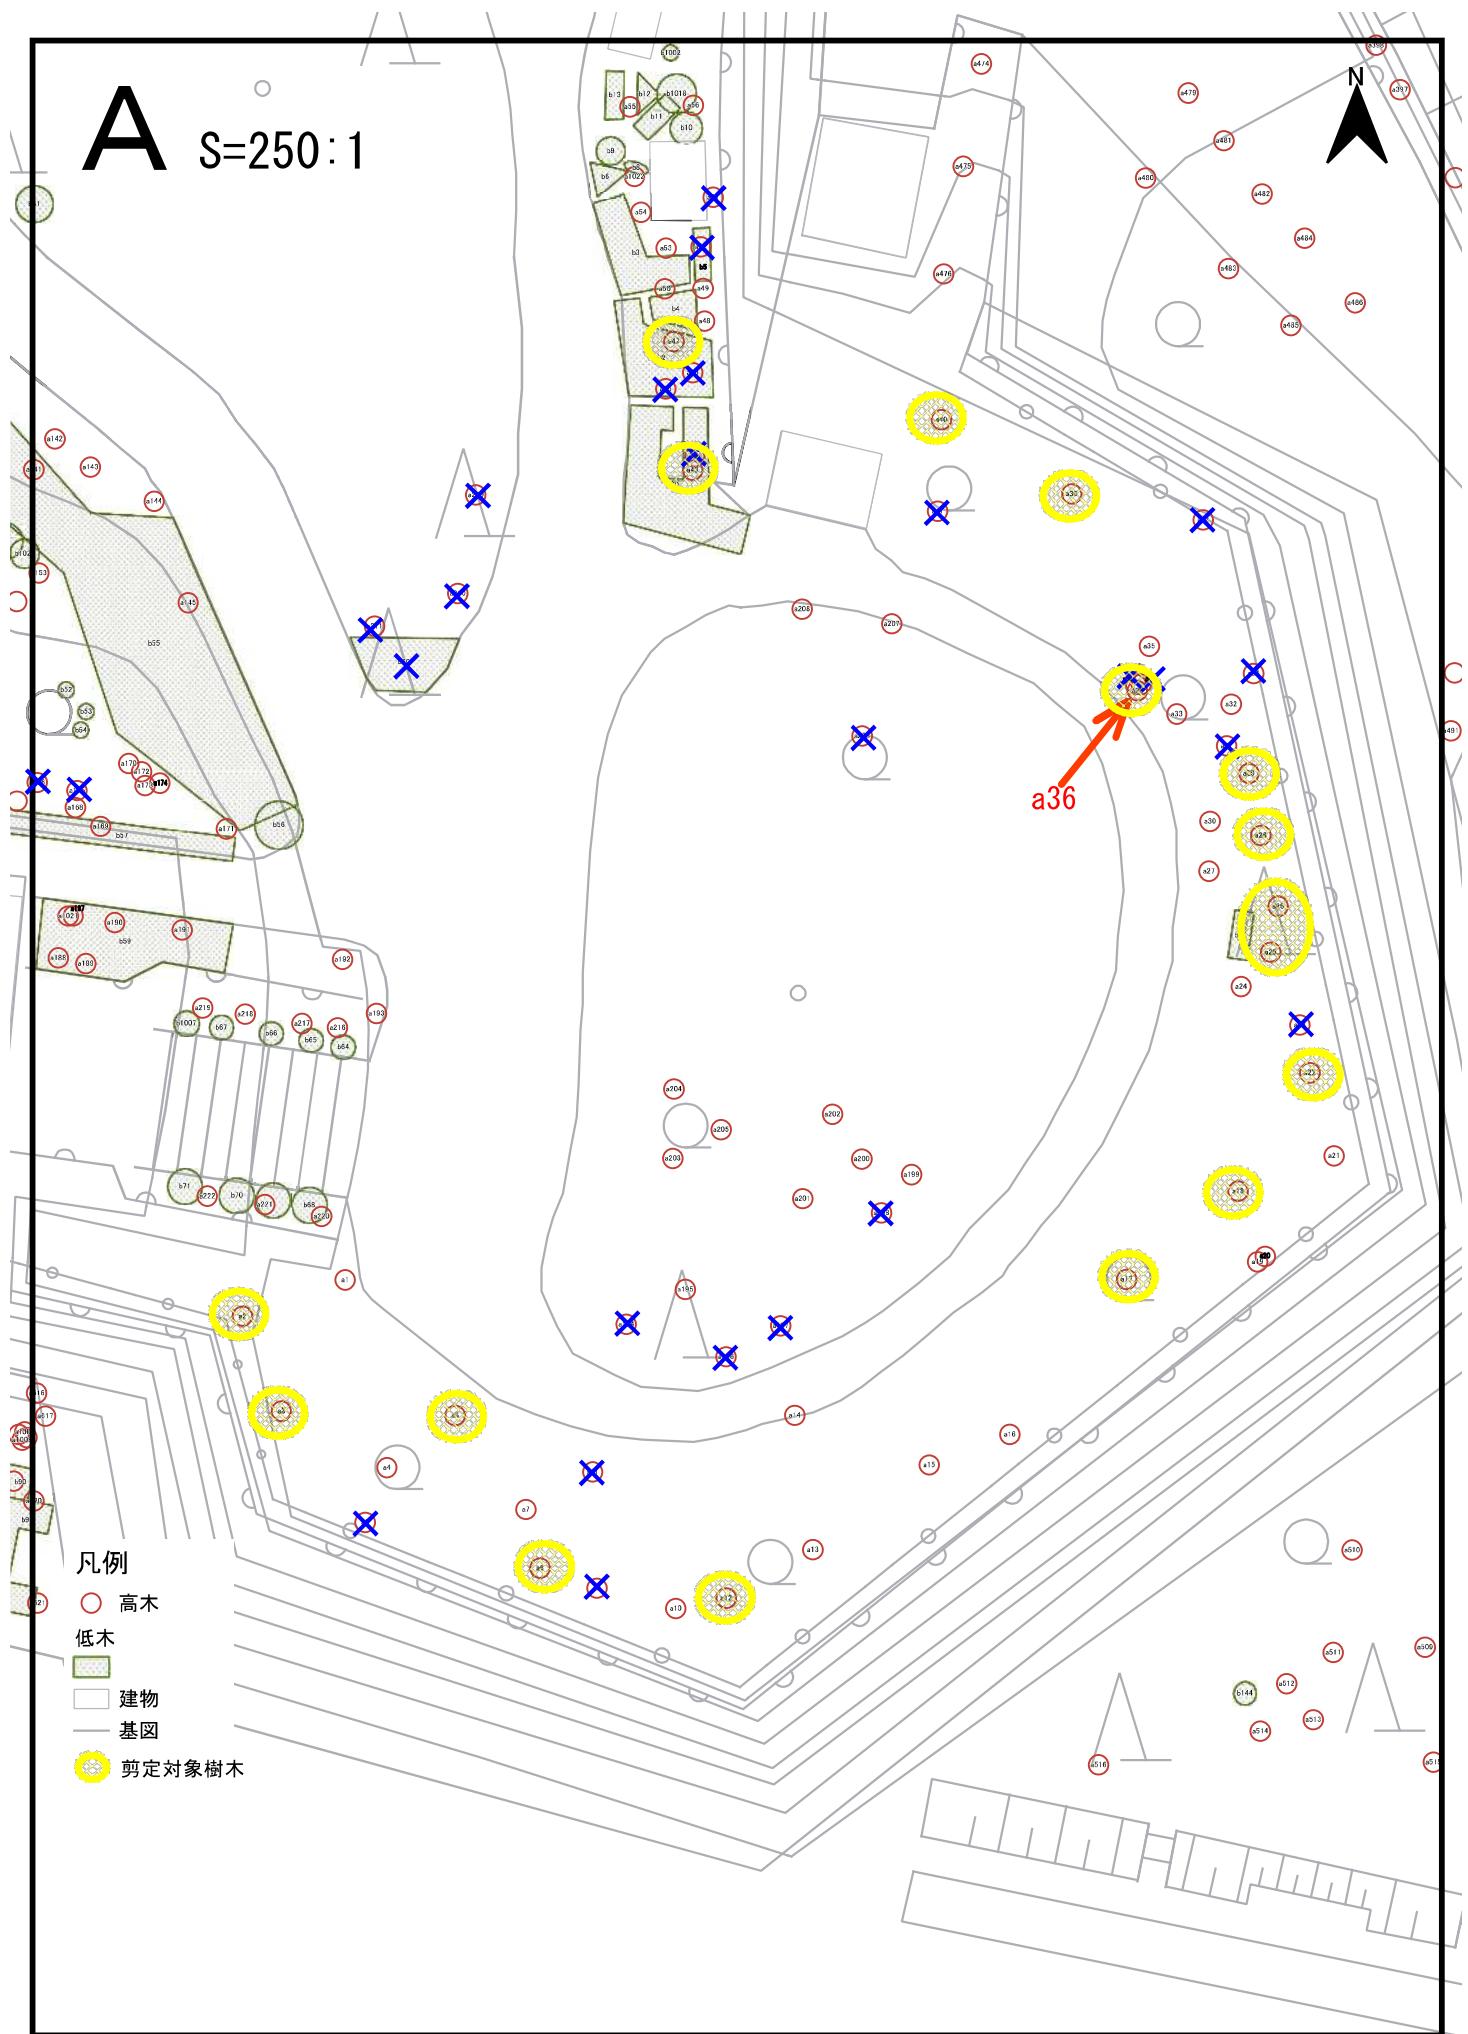

B

S=250:1

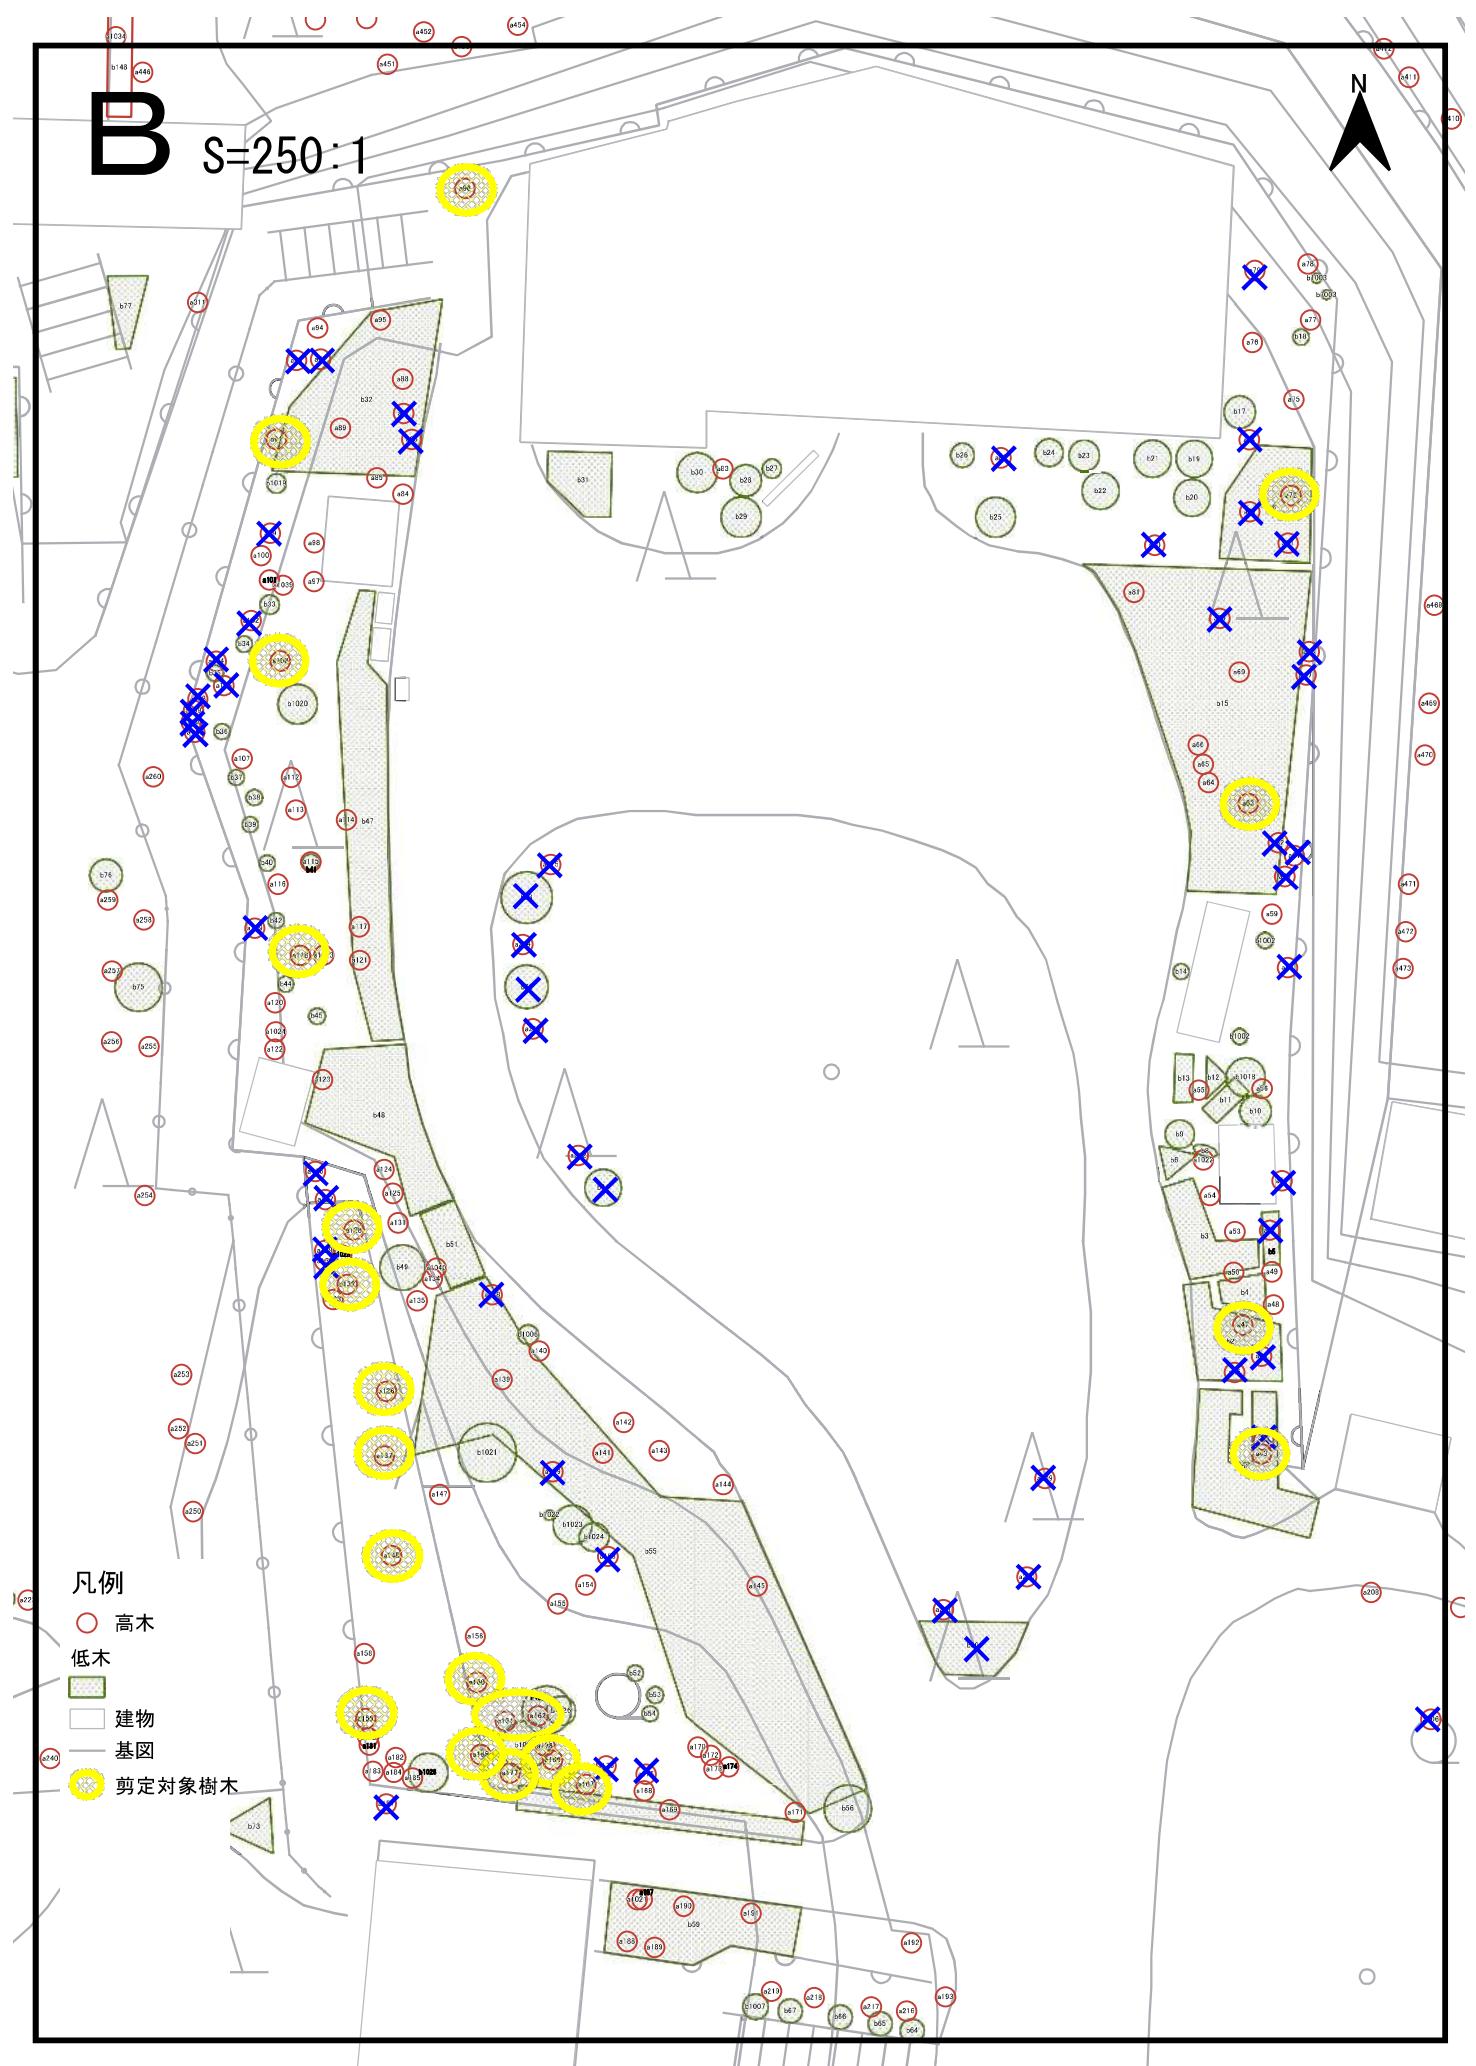

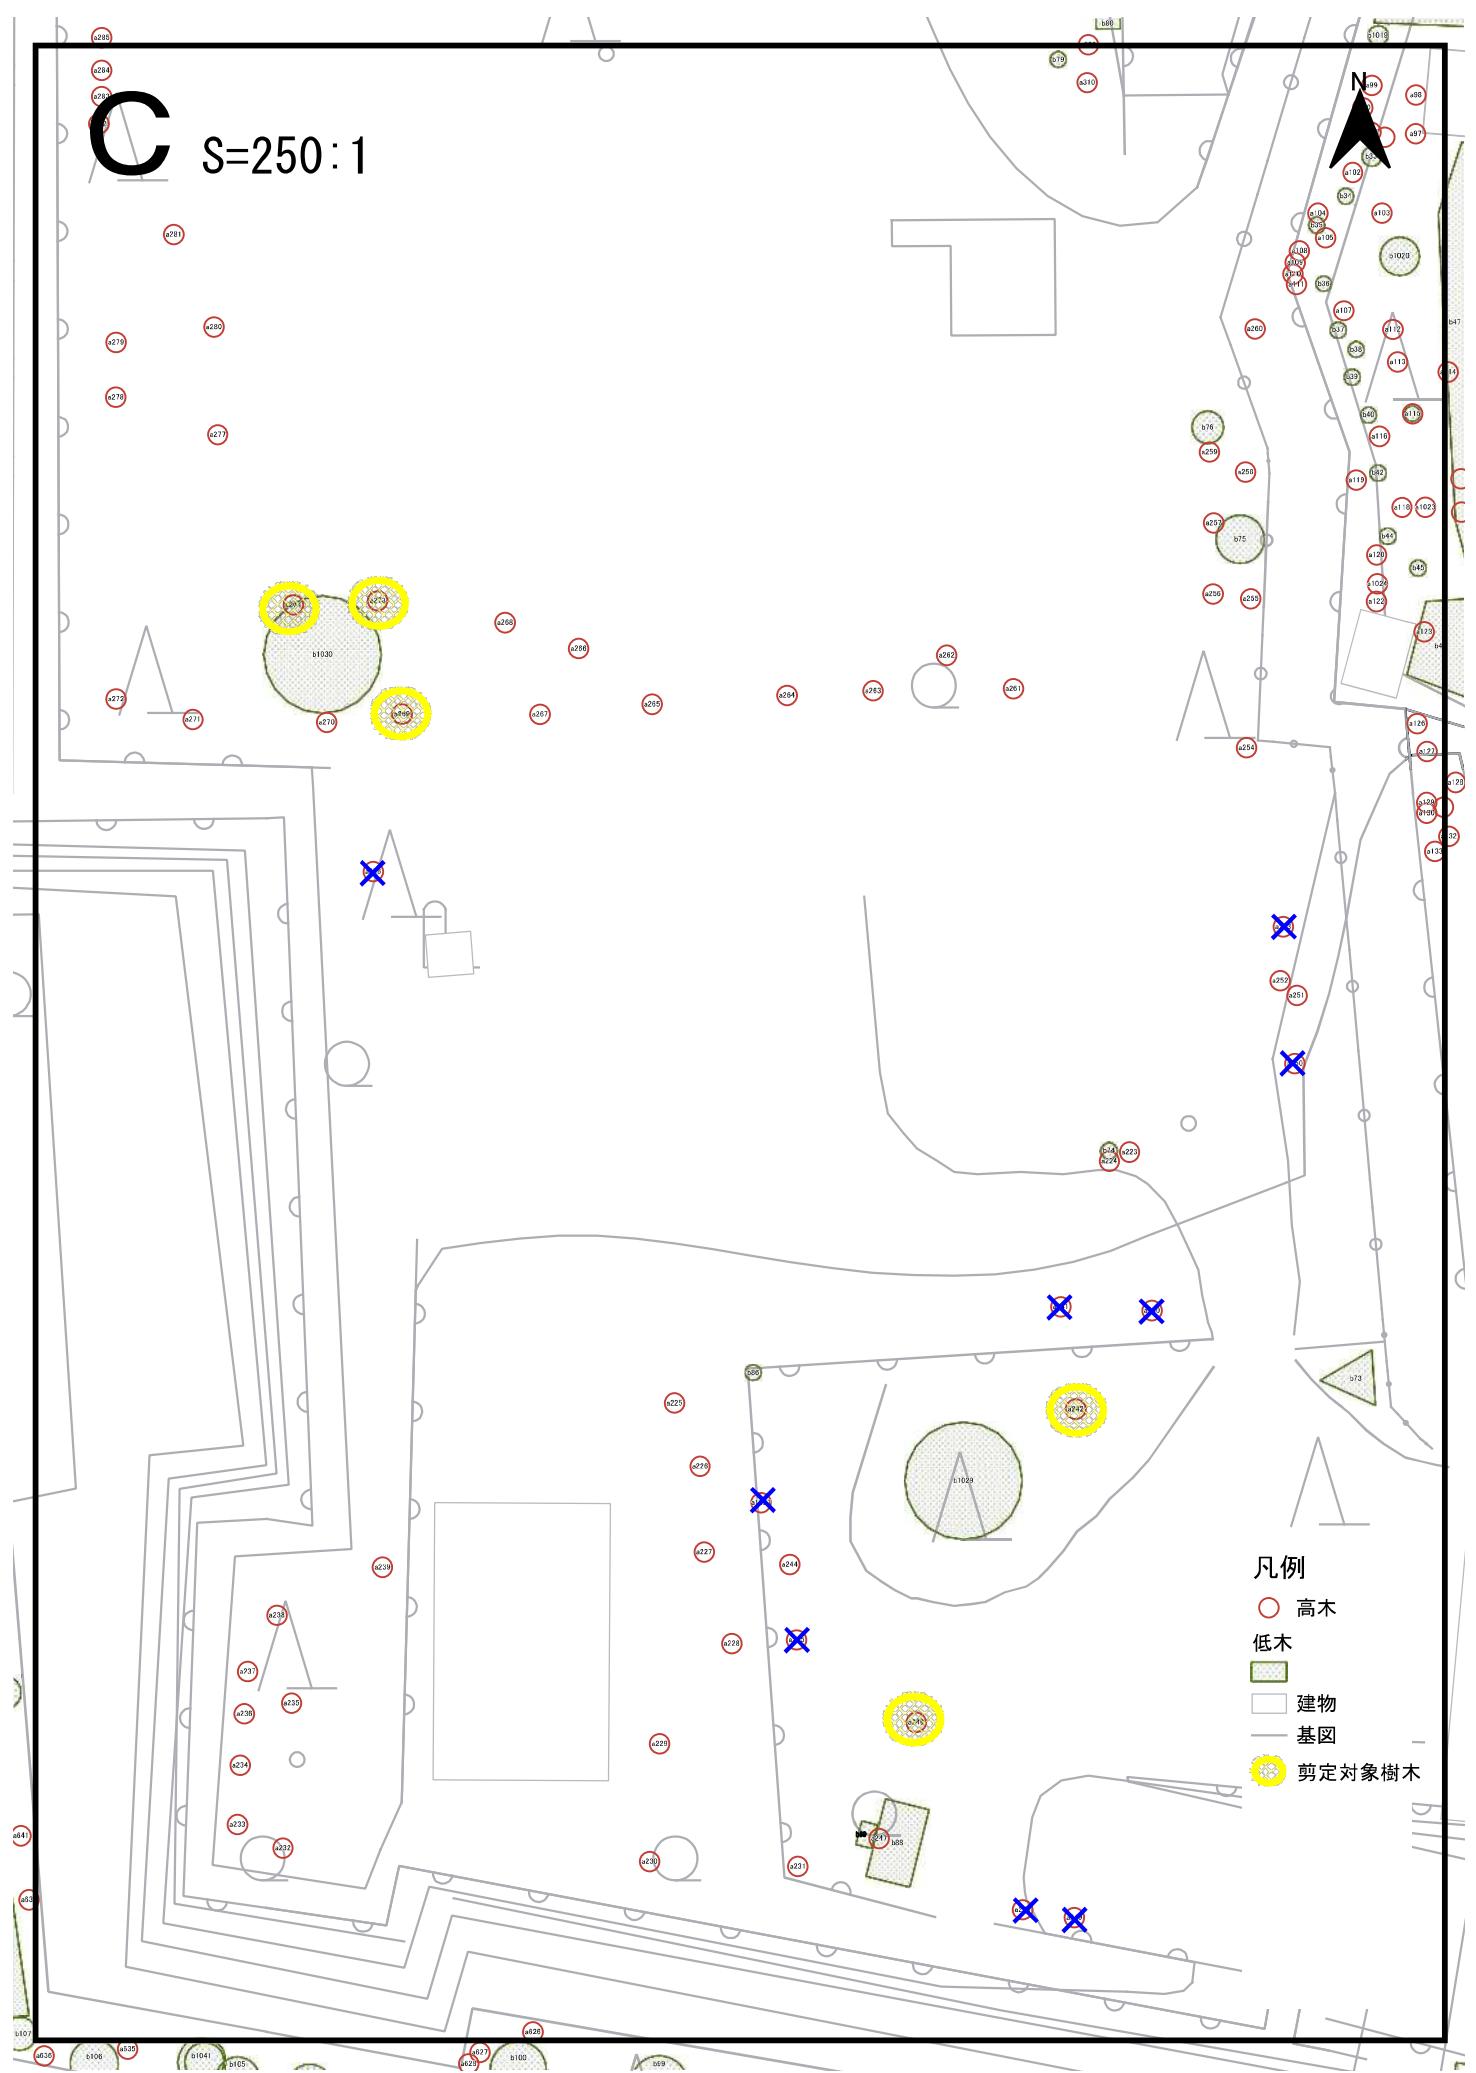

41

S=250:1

E

S=250:1

N


凡例

○ 高木

國外

建物

— 基図

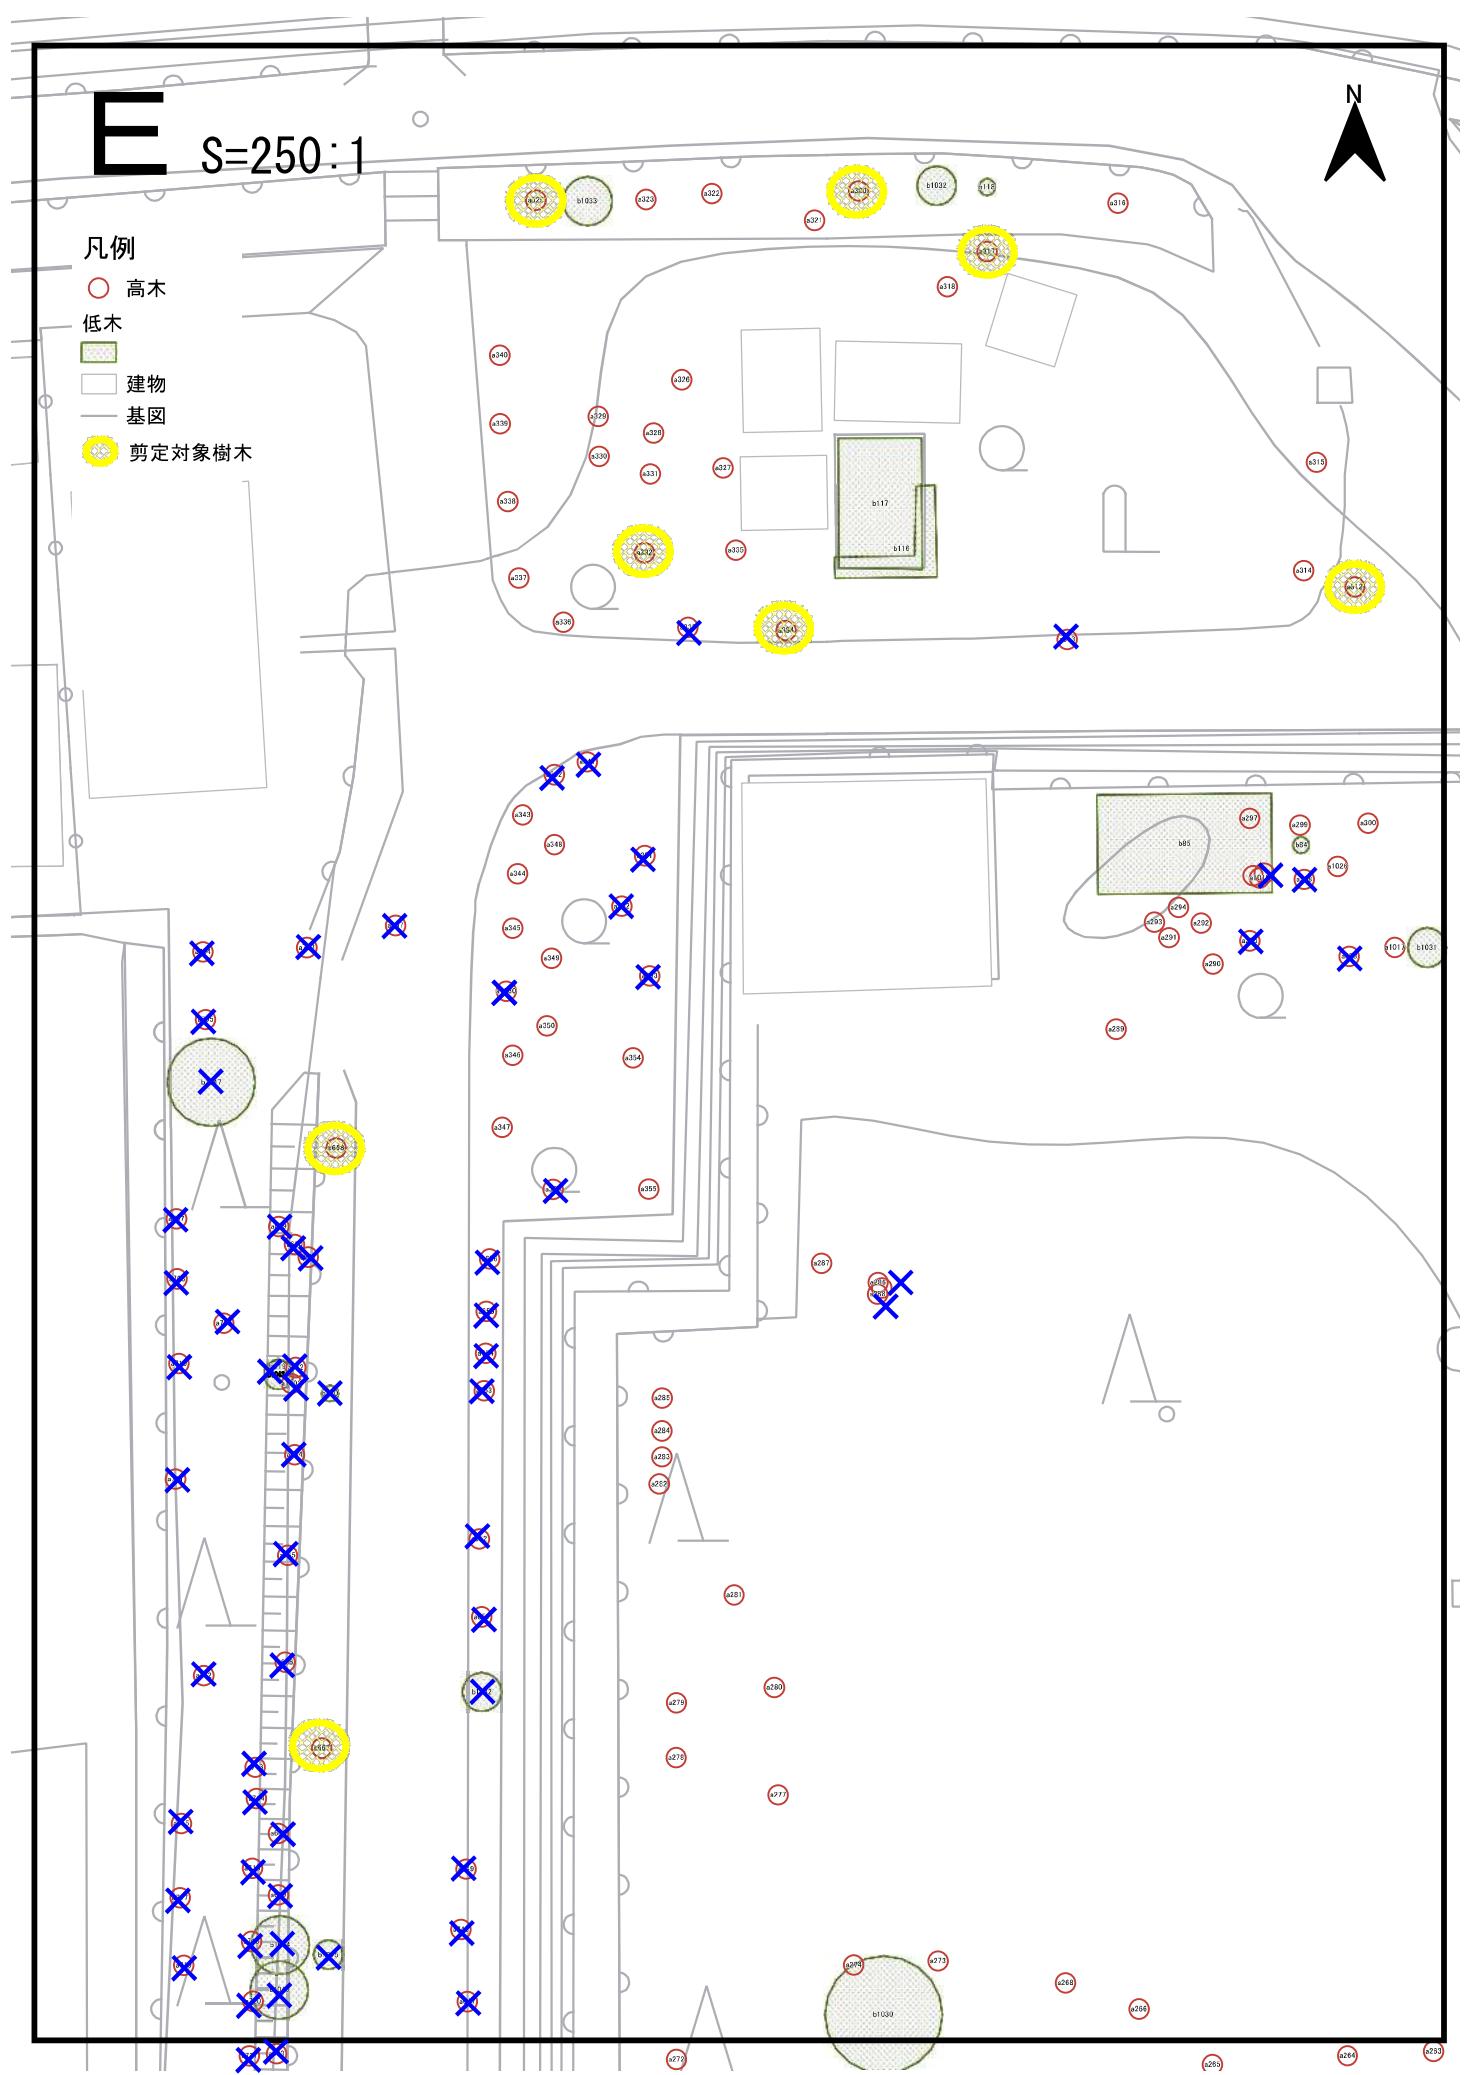

F

~~S=250:1~~





凡例

高木
低木

國外

- 建物
- 基図
- 剪定対象樹木

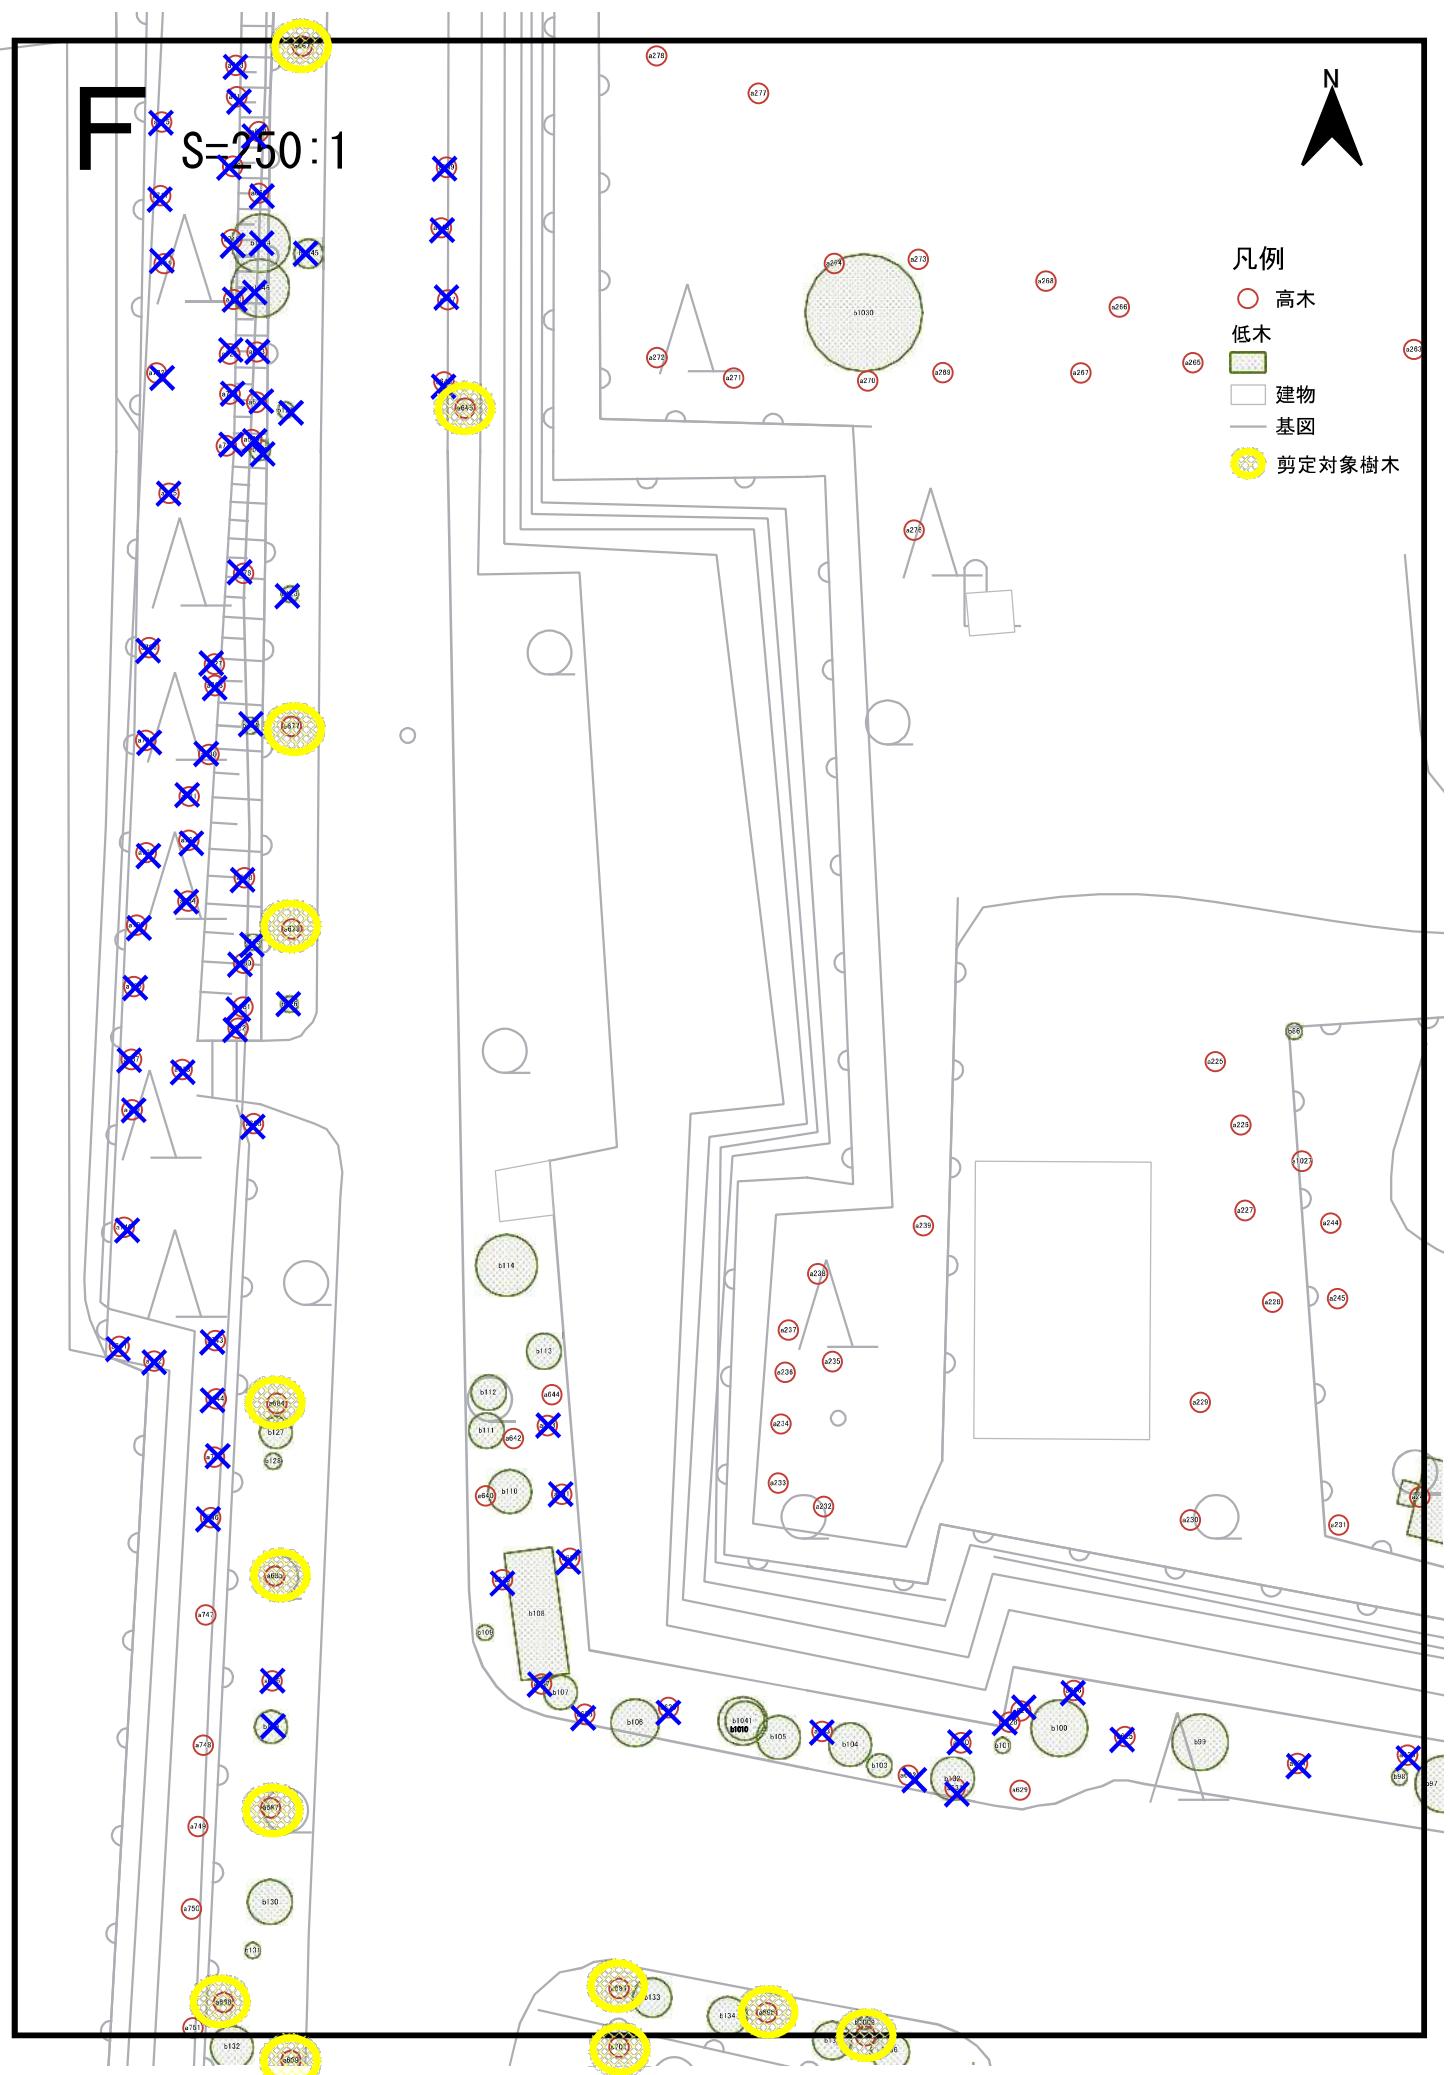

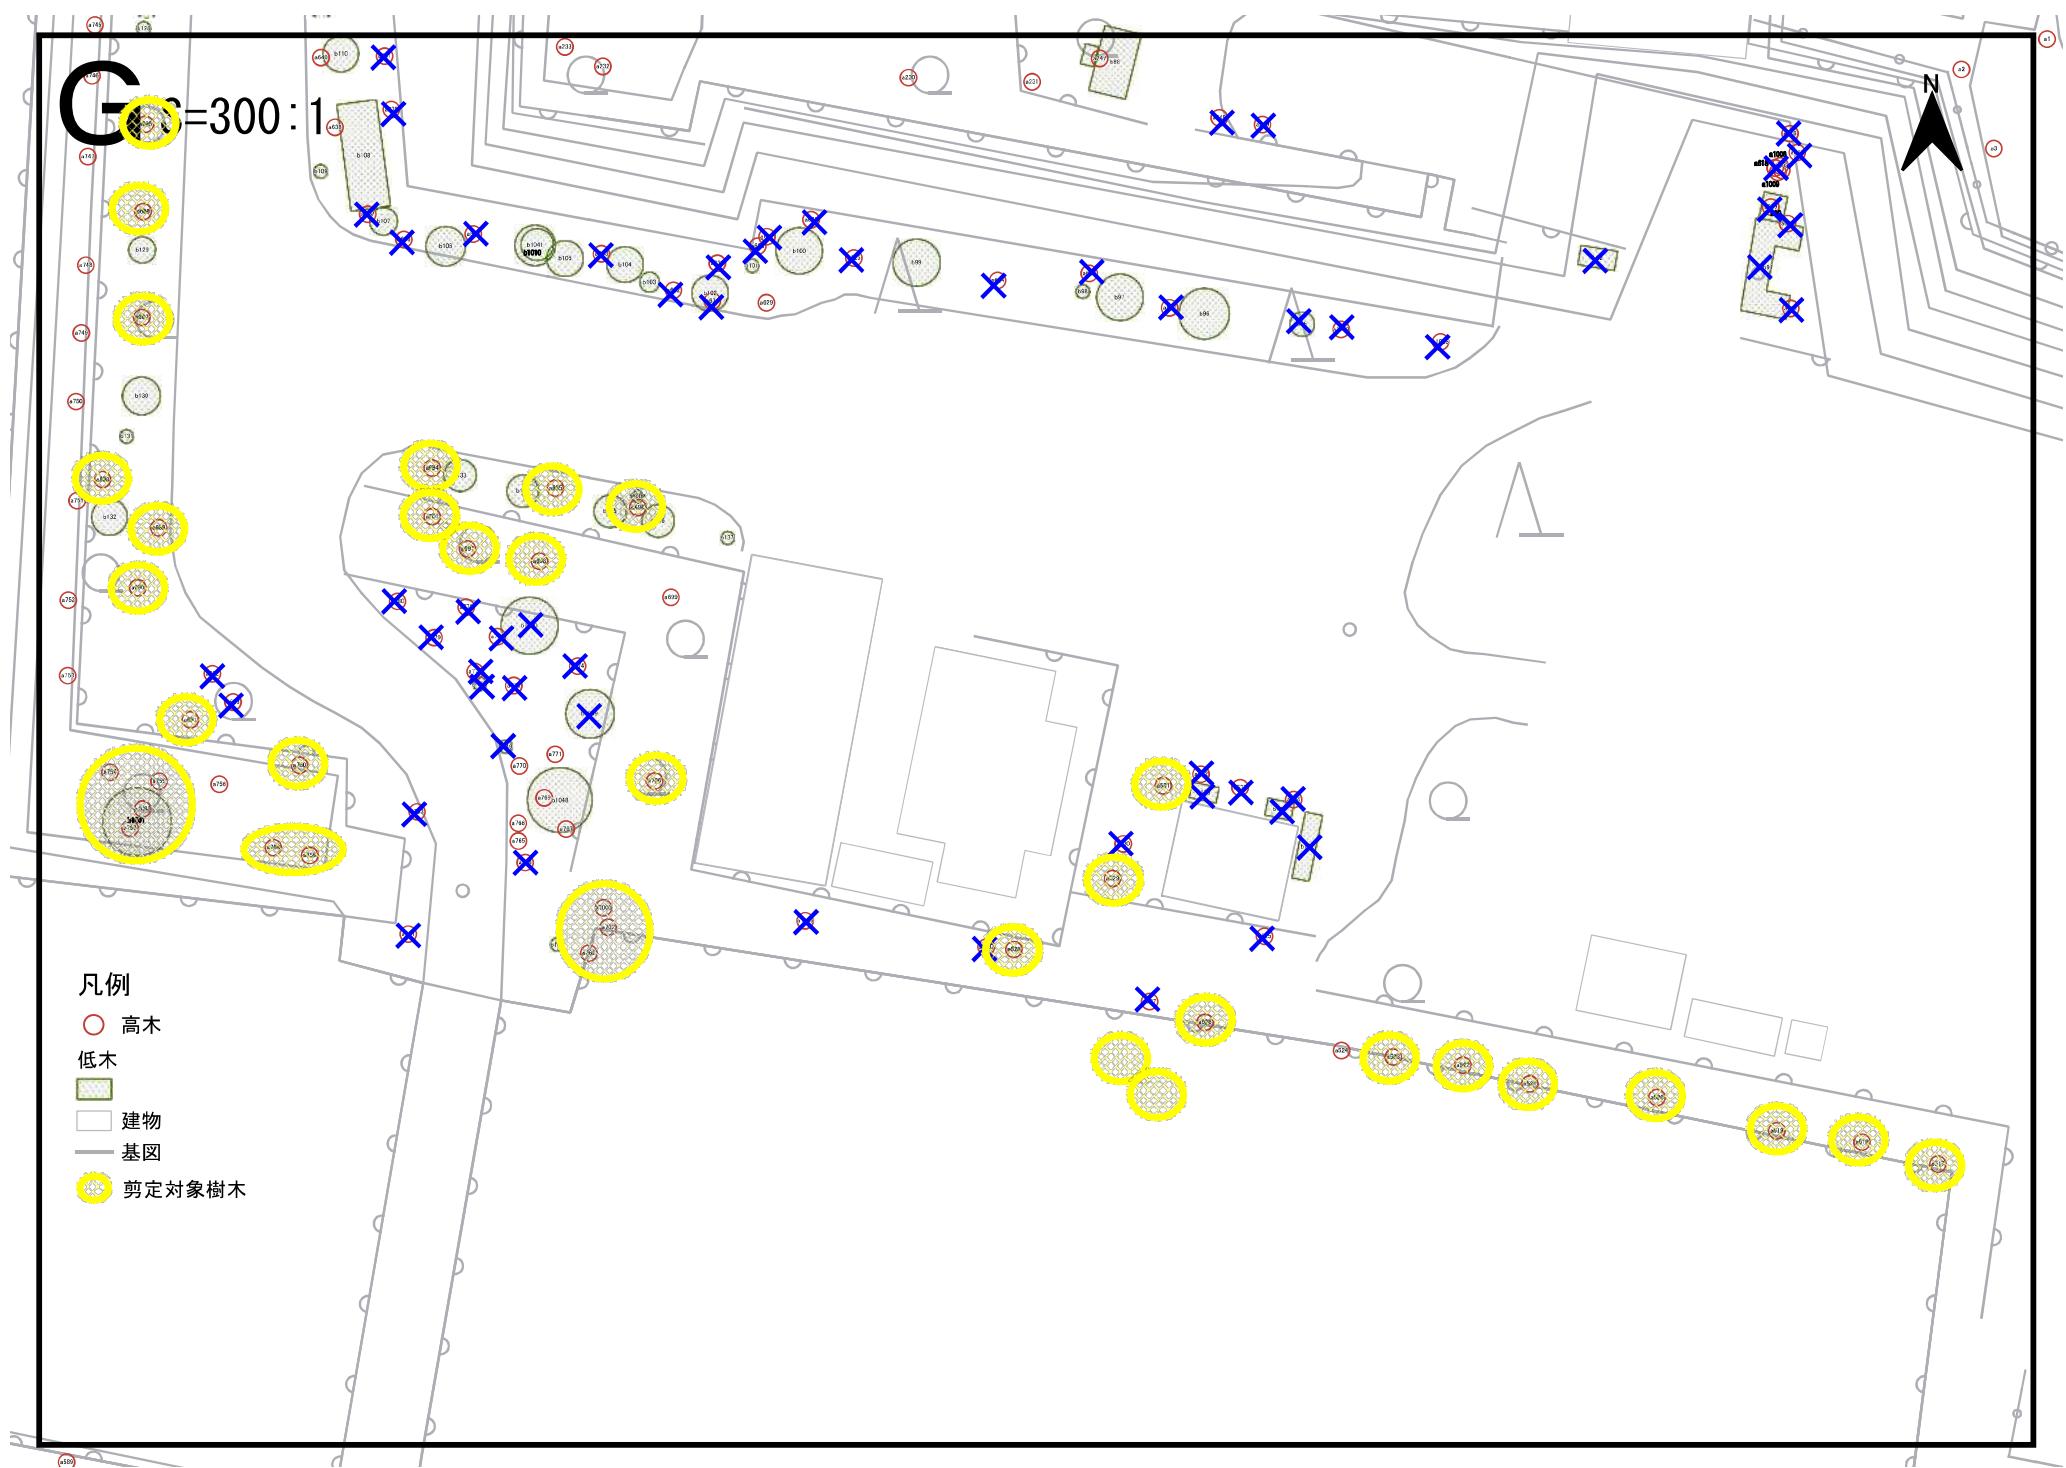


H S=250:1

N

凡例

- 高木
 - 低木
 -  建物
 -  基図
 -  剪定対象樹木

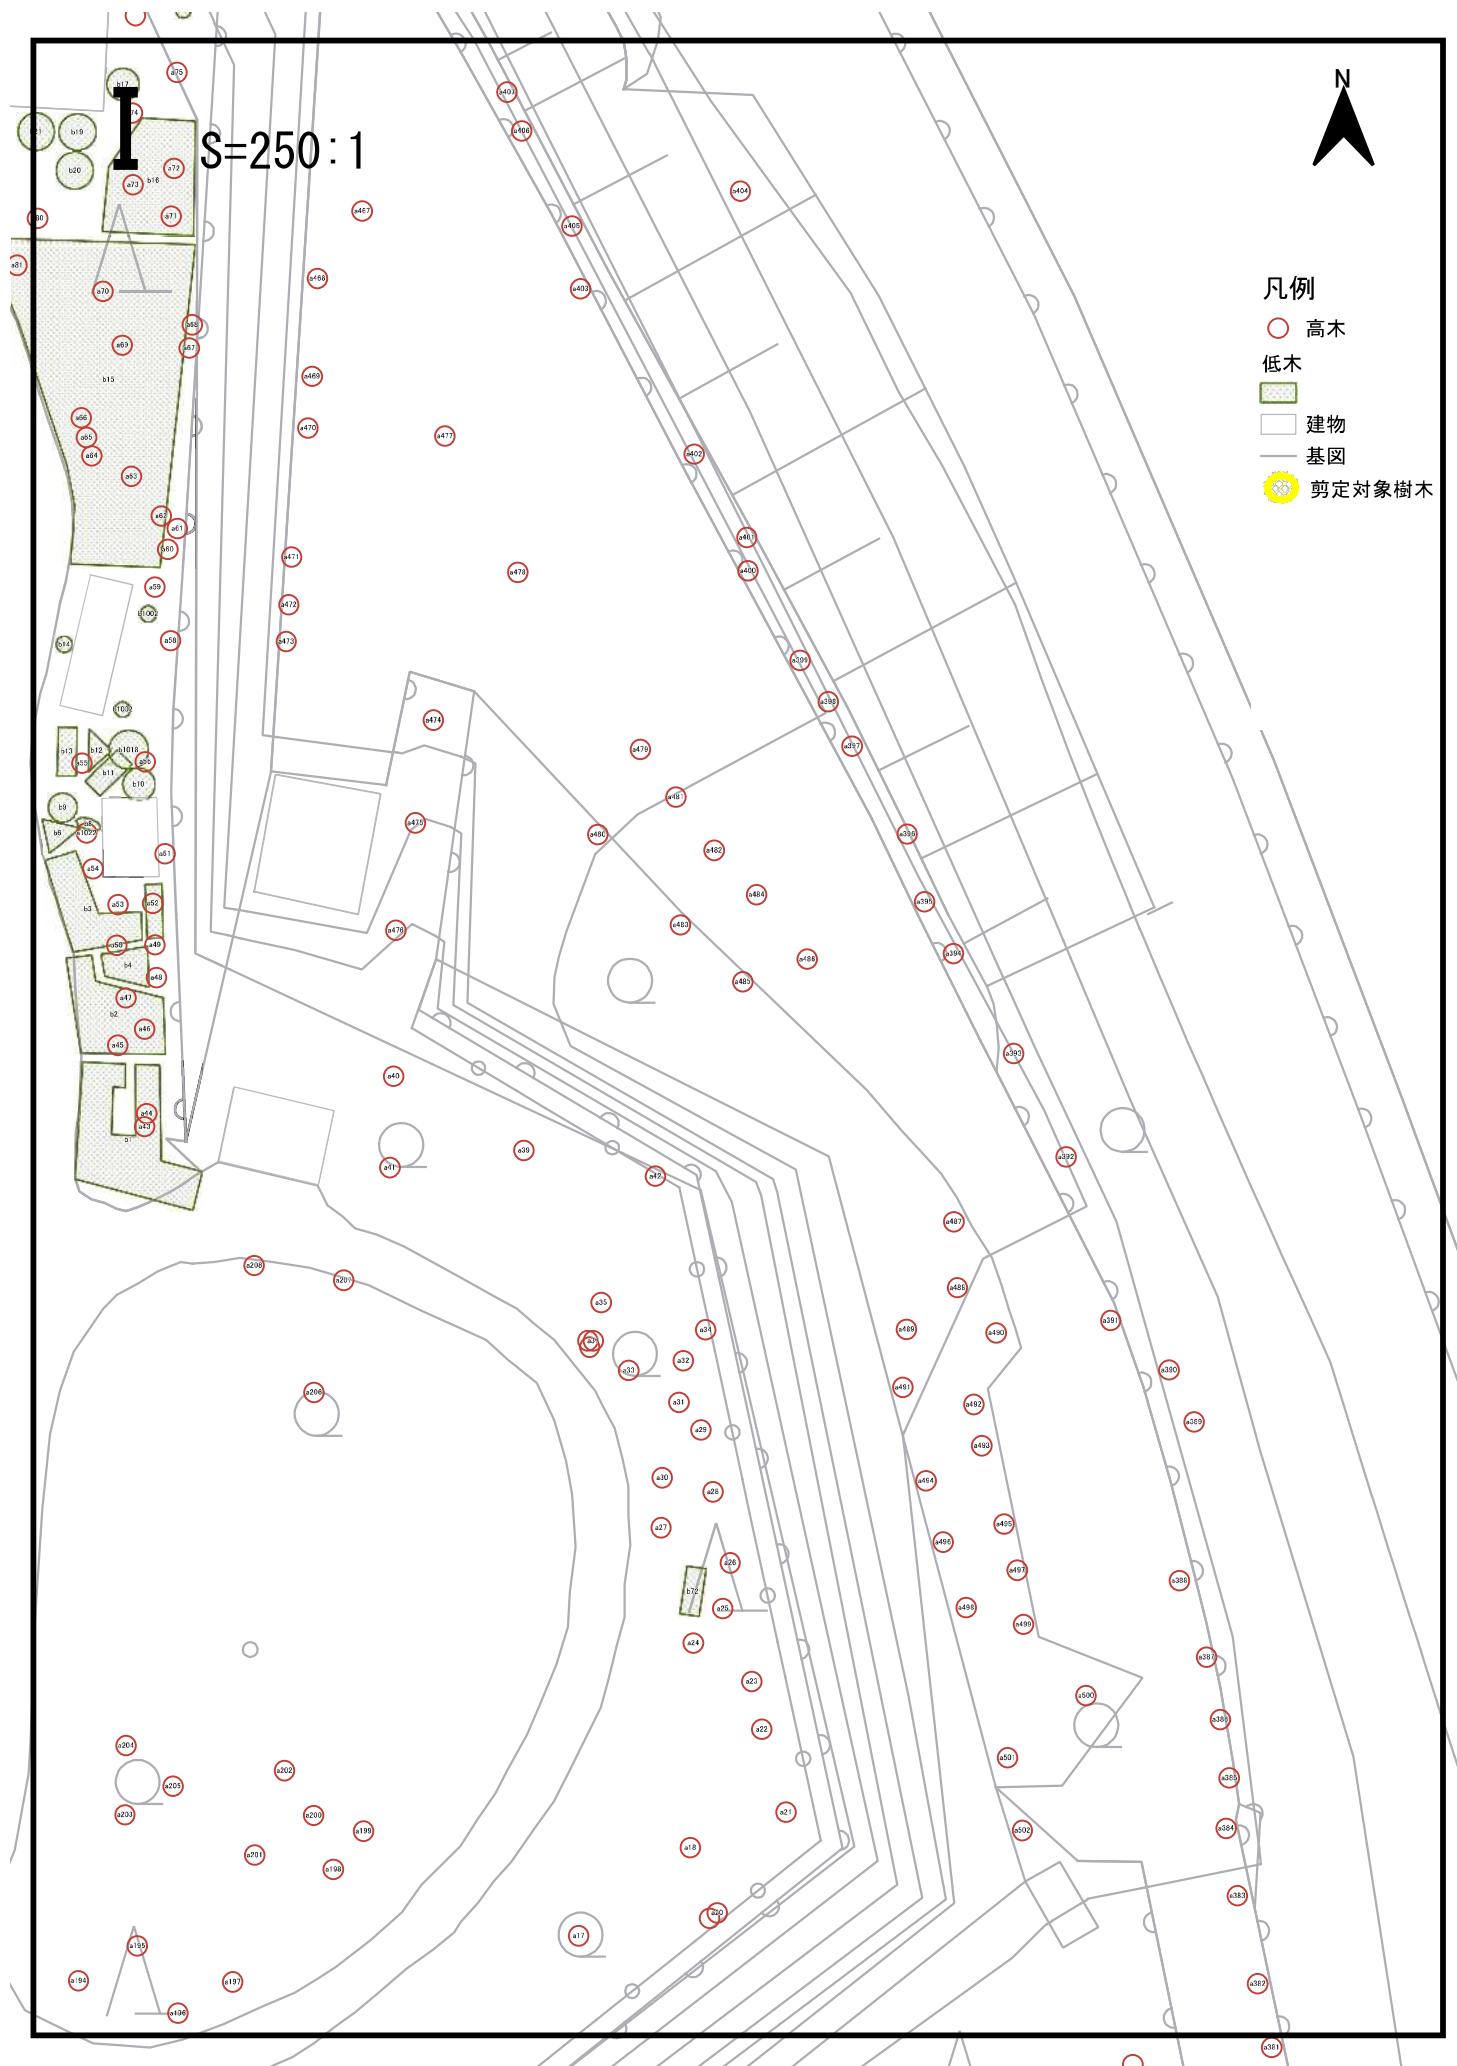

J

~~S=250:1~~

N

凡例

○ 高木

低木

建筑物

延
基

剪定対象樹木

K S=250:1

N

凡例

○ 高木

低木

建物

基础

剪定対象樹木



L

S=250:1

N

凡例

○ 高木

低木

建物

建物
— 基図

剪定対象樹木

P

b17S

b592 b174 b591