



岡東浄化センターほかクレーン修理

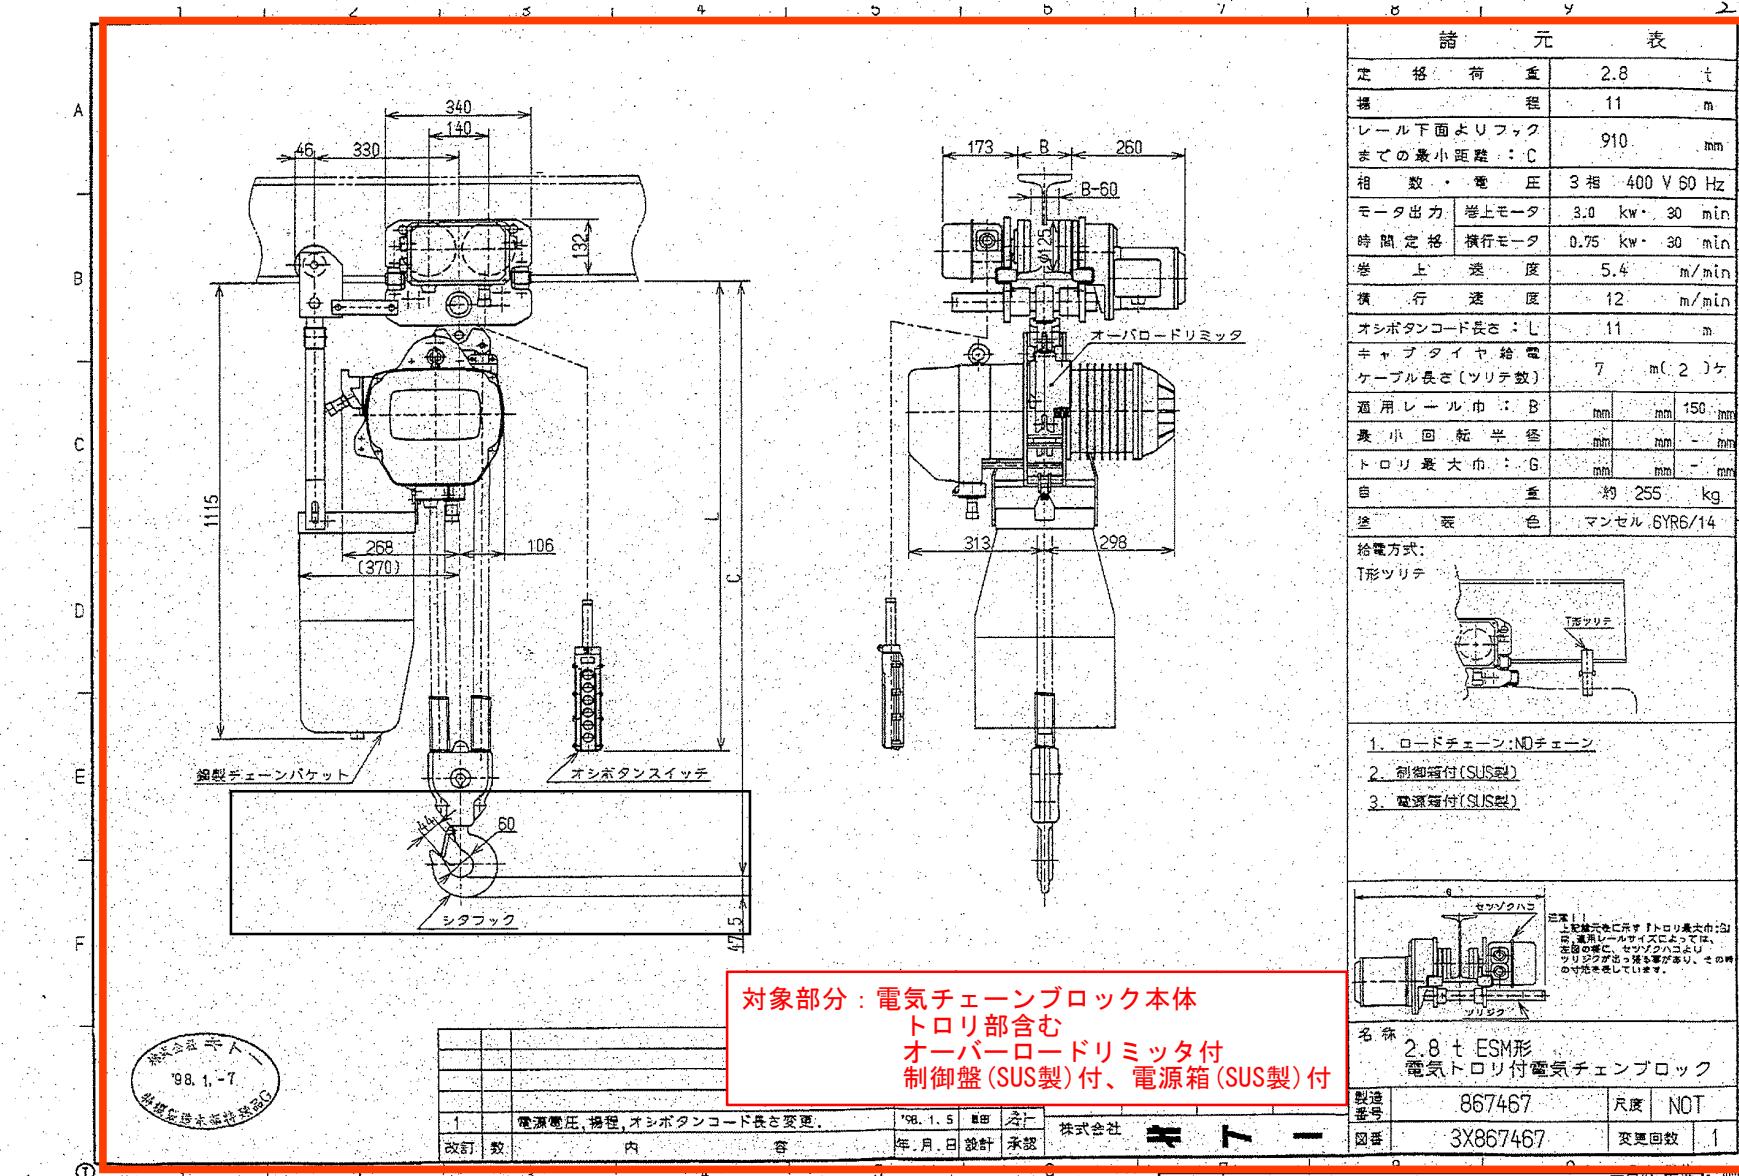

既設クレーン詳細図

設置場所:瀬戸雨水ポンプ場

既設参考図面

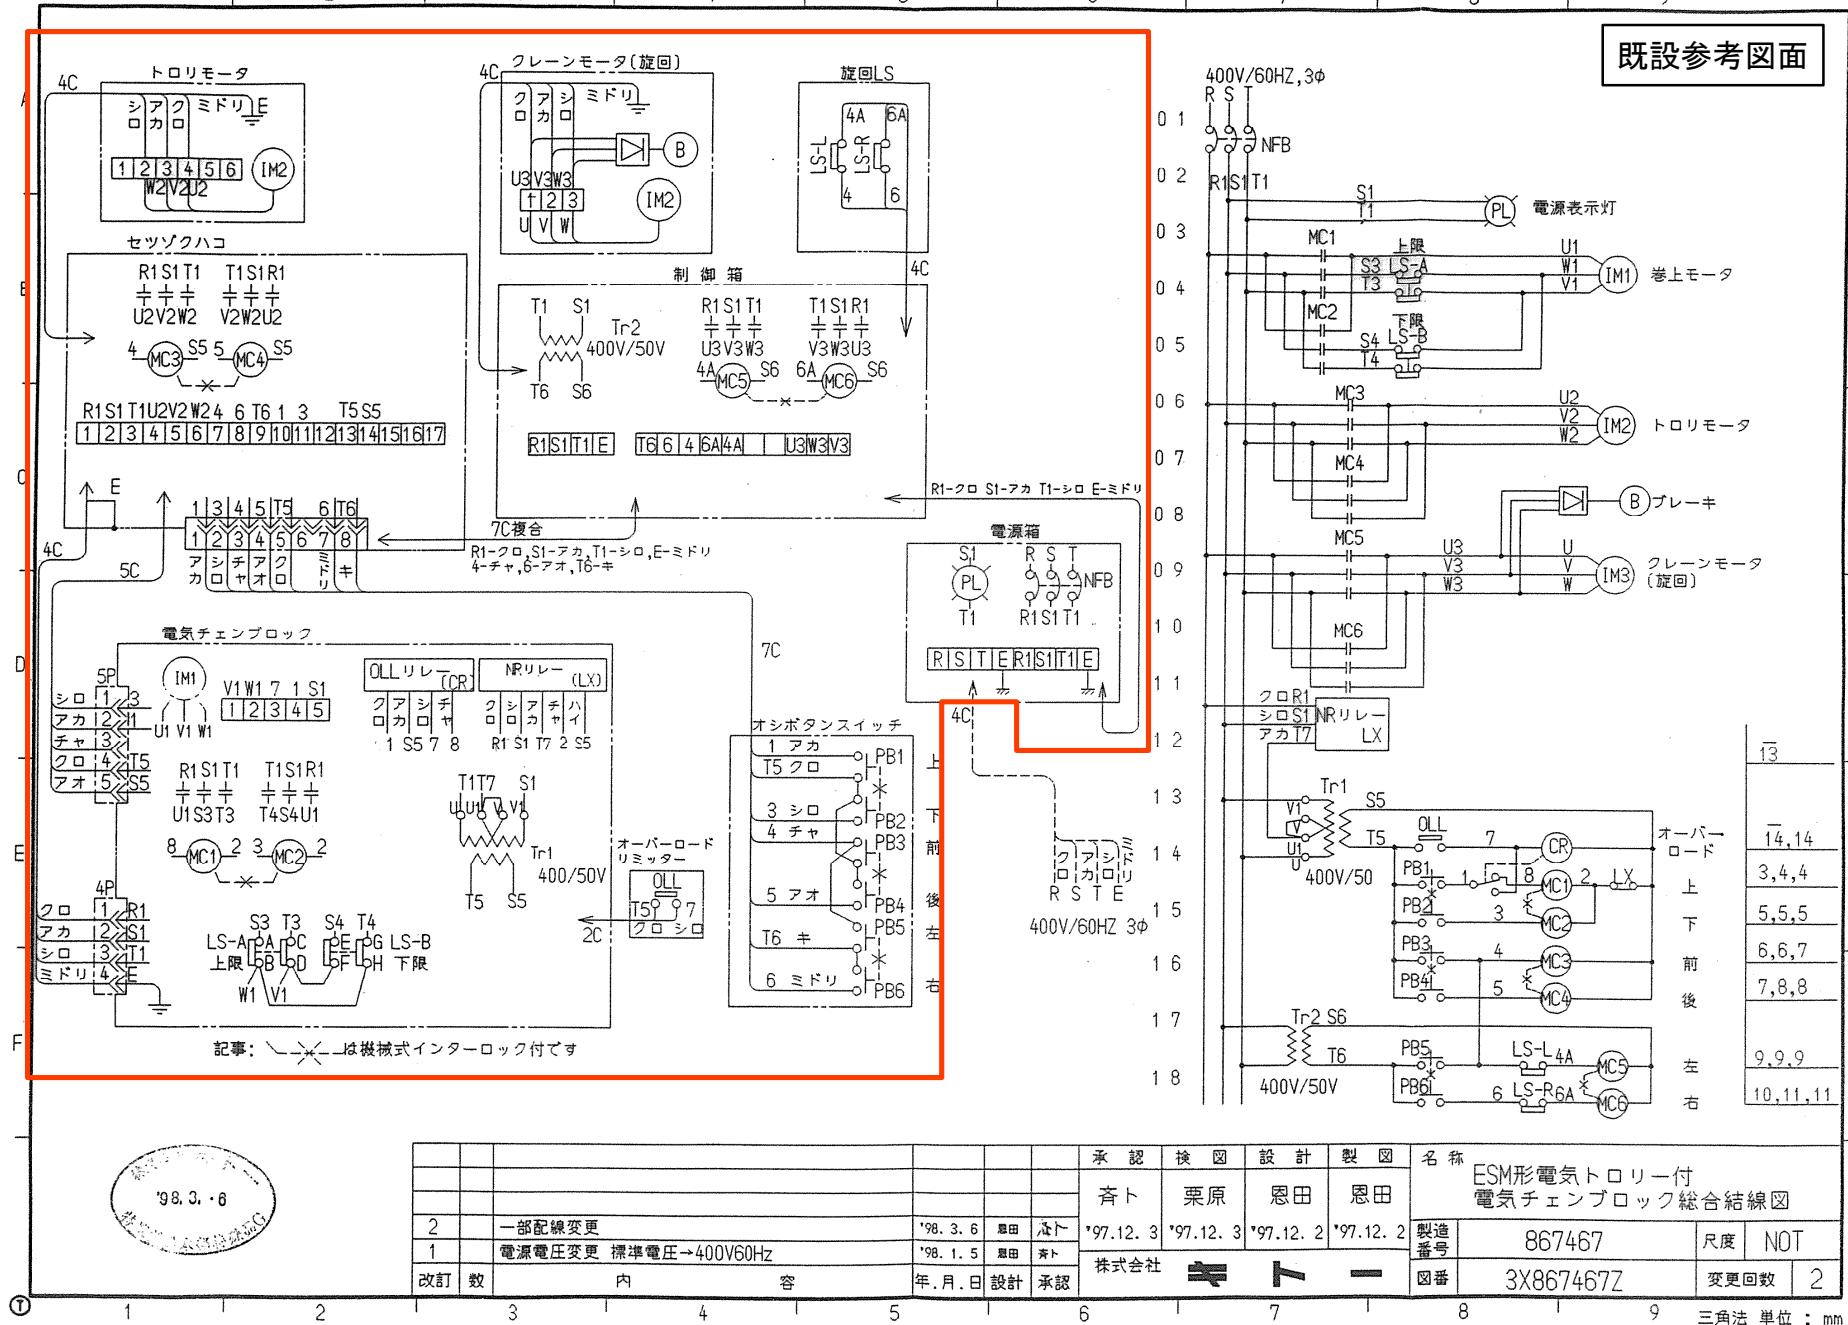

改訂	数	内 容			年.月.日	設計	承認																																								
1	1	機器名称追加			98.1.6	栗原	齊卜																																								
既設参考図面																																															
<table border="1" style="width: 100%; border-collapse: collapse;"> <tr> <th>承認</th> <th>換図</th> <th>設計</th> <th>製図</th> <th>名 称</th> <td colspan="3"></td> </tr> <tr> <td>齊卜</td> <td>栗原</td> <td>恩田</td> <td>恩田</td> <td>電 源 箱</td> <td colspan="3"></td> </tr> <tr> <td>97.12.4</td> <td>97.12.4</td> <td>97.12.4</td> <td>97.12.4</td> <td></td> <td colspan="3"></td> </tr> <tr> <td colspan="4"></td> <td>製造番号</td> <td>867467</td> <td>尺度</td> <td>1/5</td> </tr> <tr> <td colspan="4"></td> <td>図番</td> <td>4X867467Q-1</td> <td>変更回数</td> <td>1</td> </tr> </table>								承認	換図	設計	製図	名 称				齊卜	栗原	恩田	恩田	電 源 箱				97.12.4	97.12.4	97.12.4	97.12.4									製造番号	867467	尺度	1/5					図番	4X867467Q-1	変更回数	1
承認	換図	設計	製図	名 称																																											
齊卜	栗原	恩田	恩田	電 源 箱																																											
97.12.4	97.12.4	97.12.4	97.12.4																																												
				製造番号	867467	尺度	1/5																																								
				図番	4X867467Q-1	変更回数	1																																								
(1) 1 2 3 4 186																																															
(2) 1 2 3 4 187																																															
三 角 汎 用 単 單 mm																																															