


破断部溶接補修

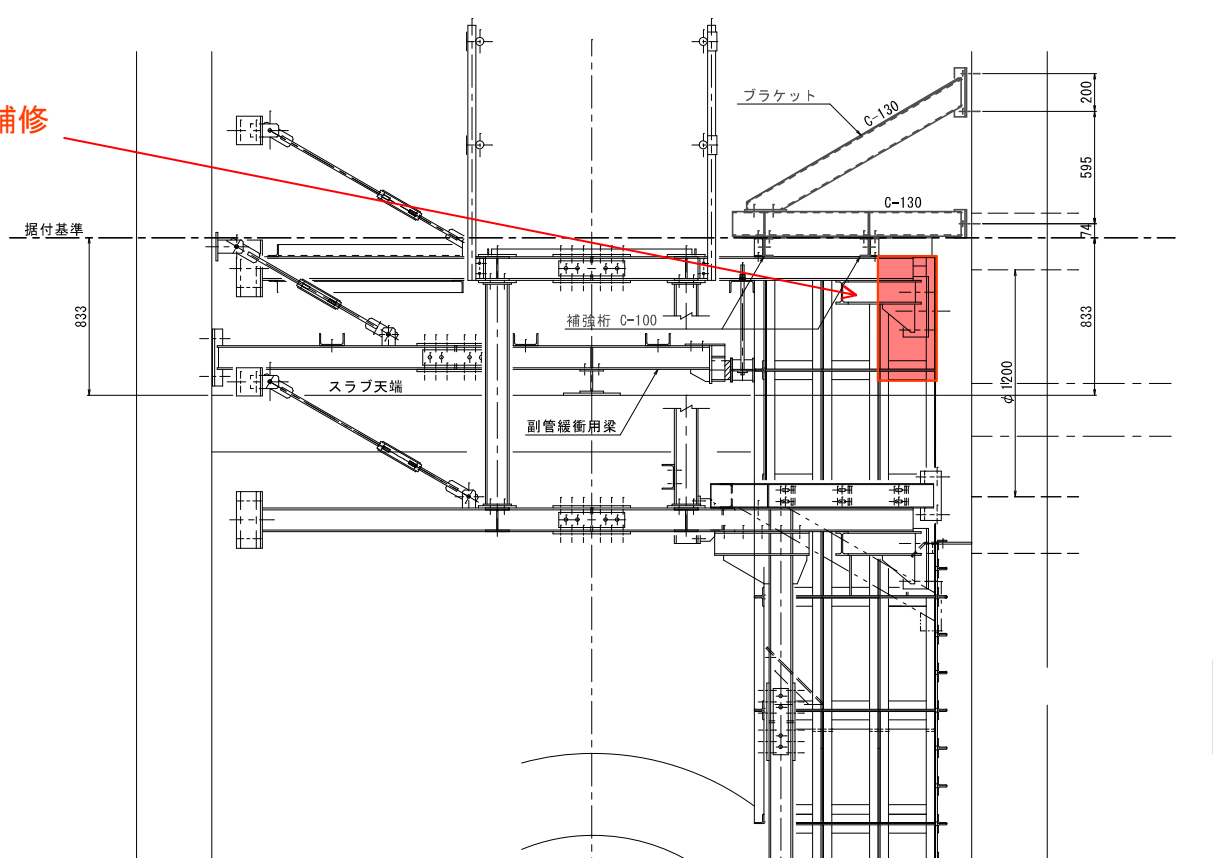

注記
1. 特記なき

部材記号表

記号	名称
C-130	[-130
C-100	[-100