
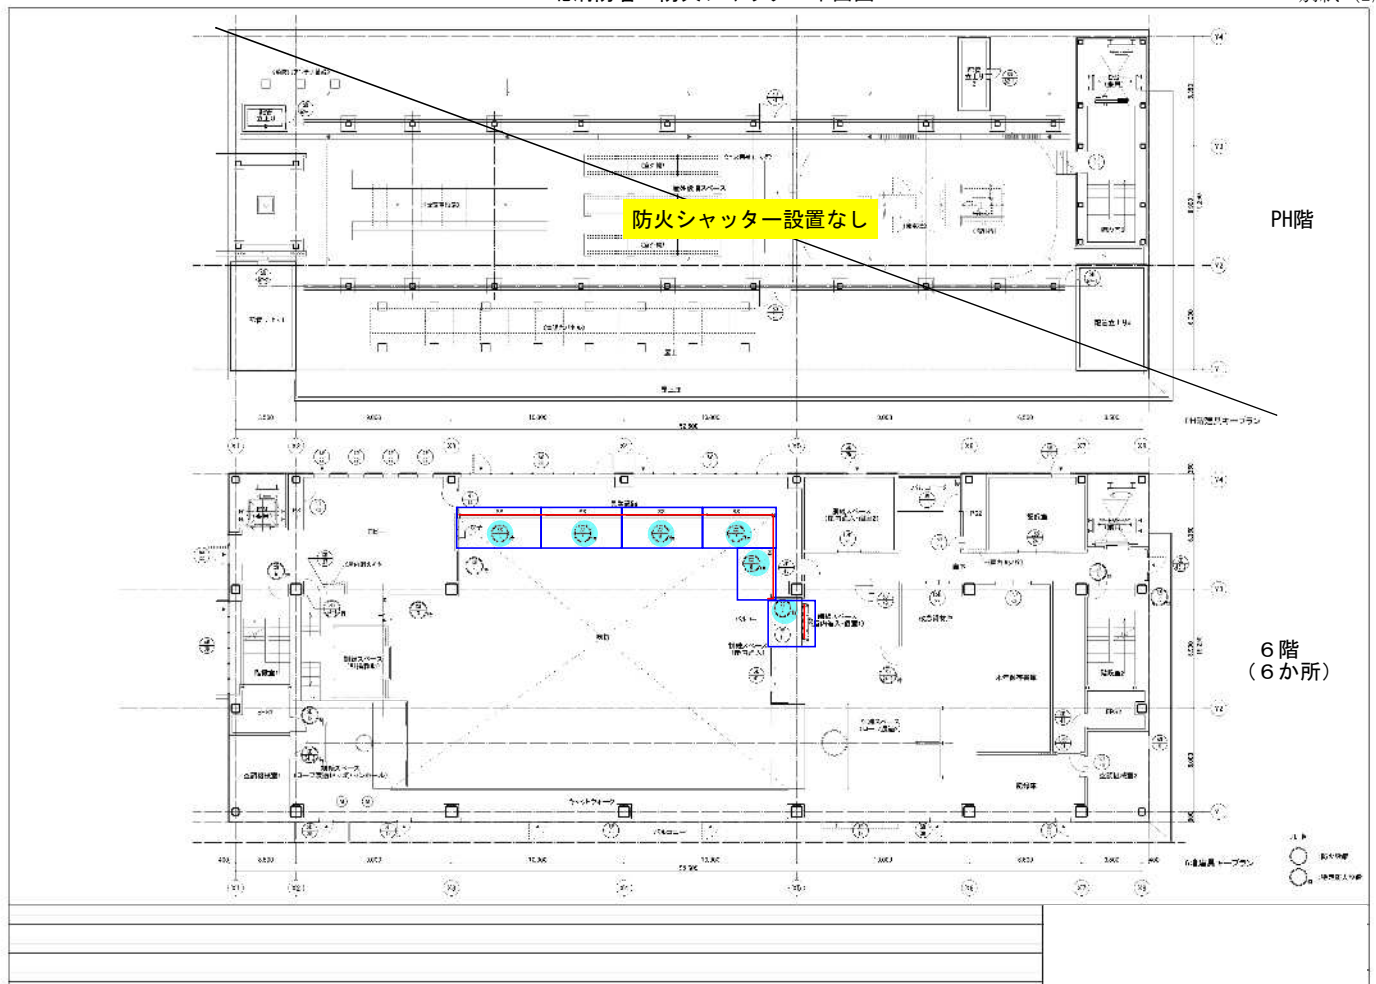


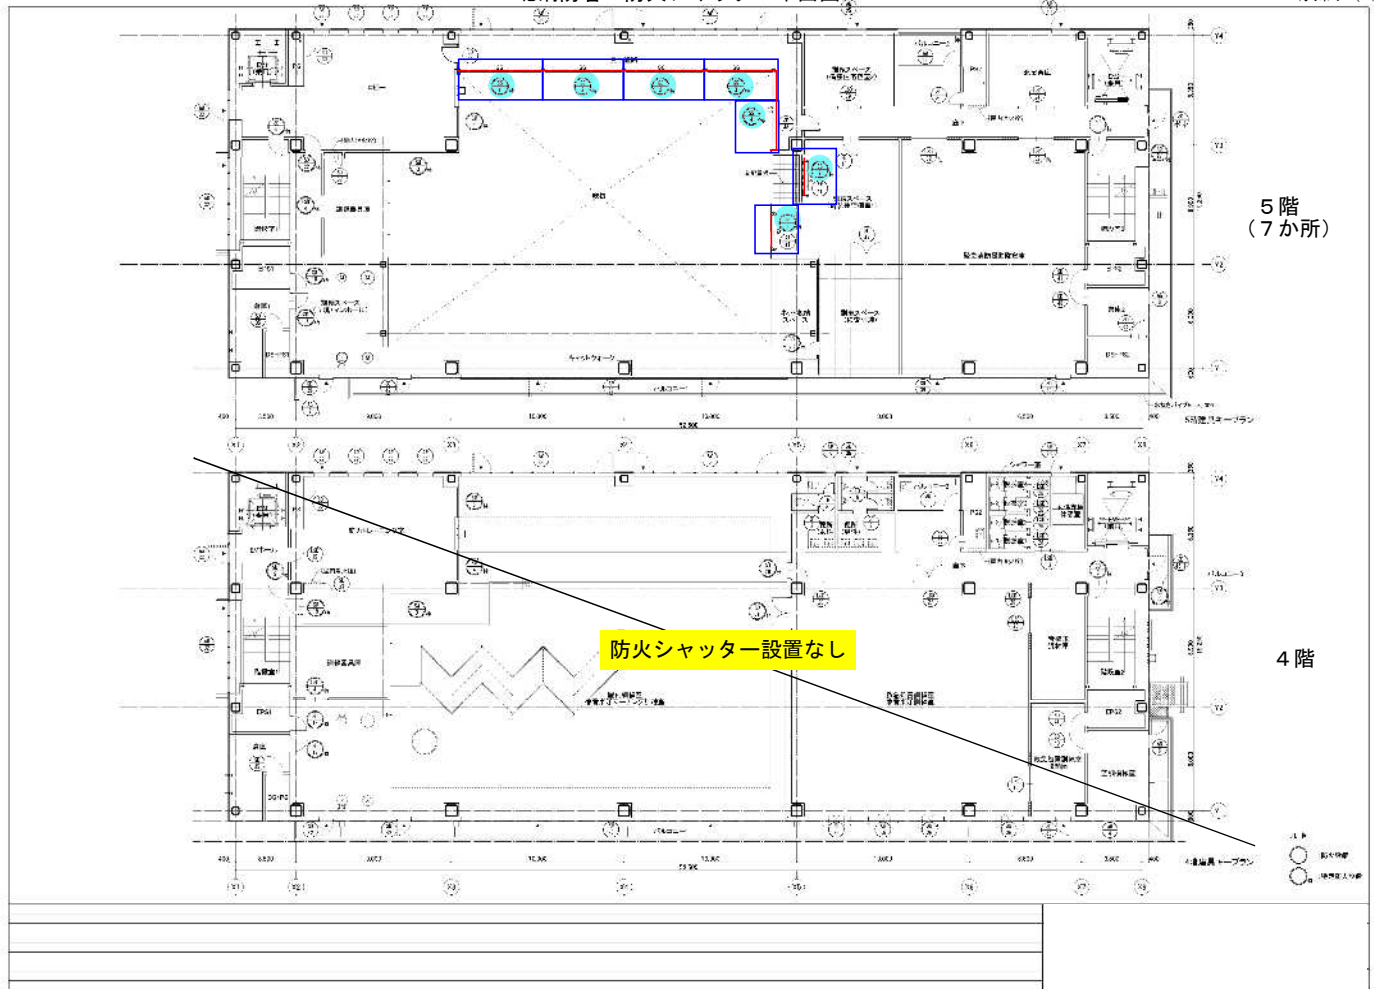

別紙 (4/10)



2階（4か所）


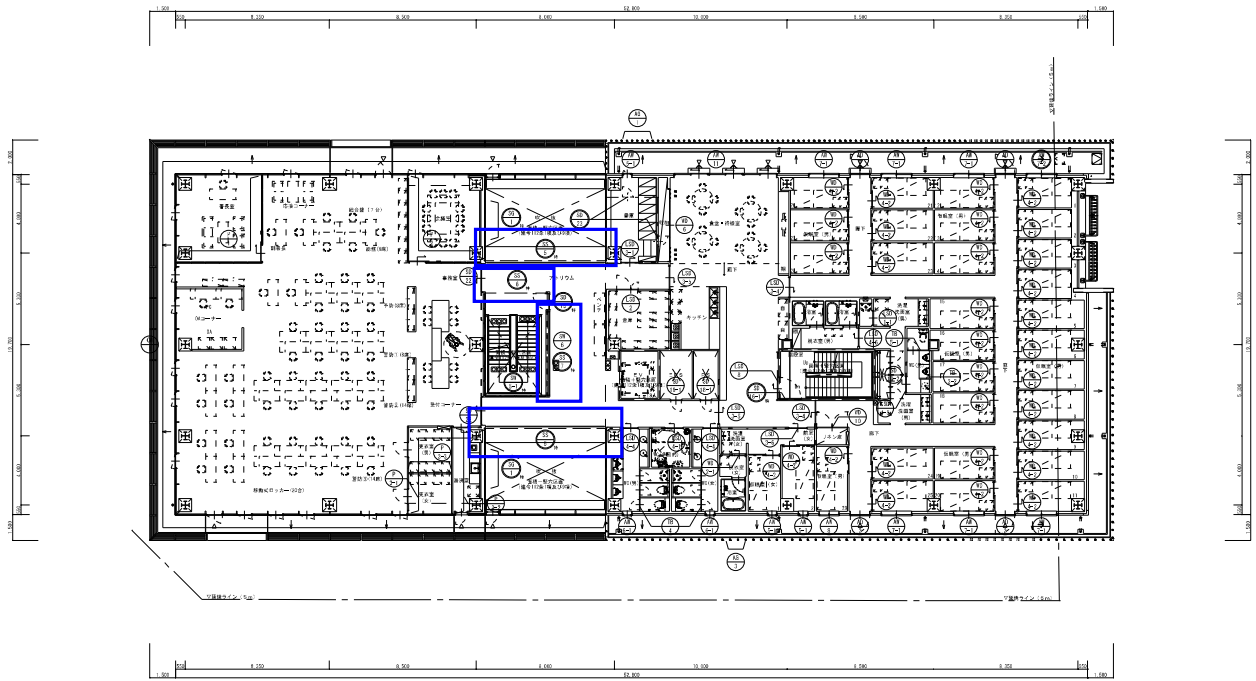



表 示	注 意 事 項

3階（4か所）

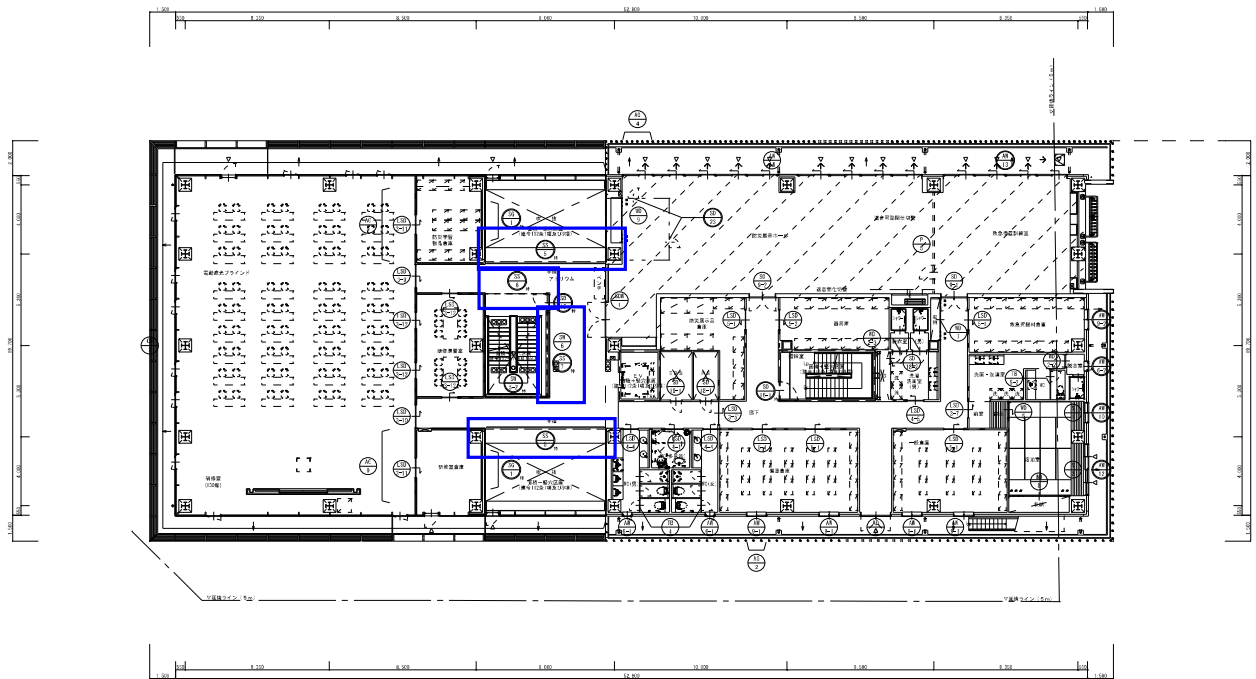


4 階 (4 か所)

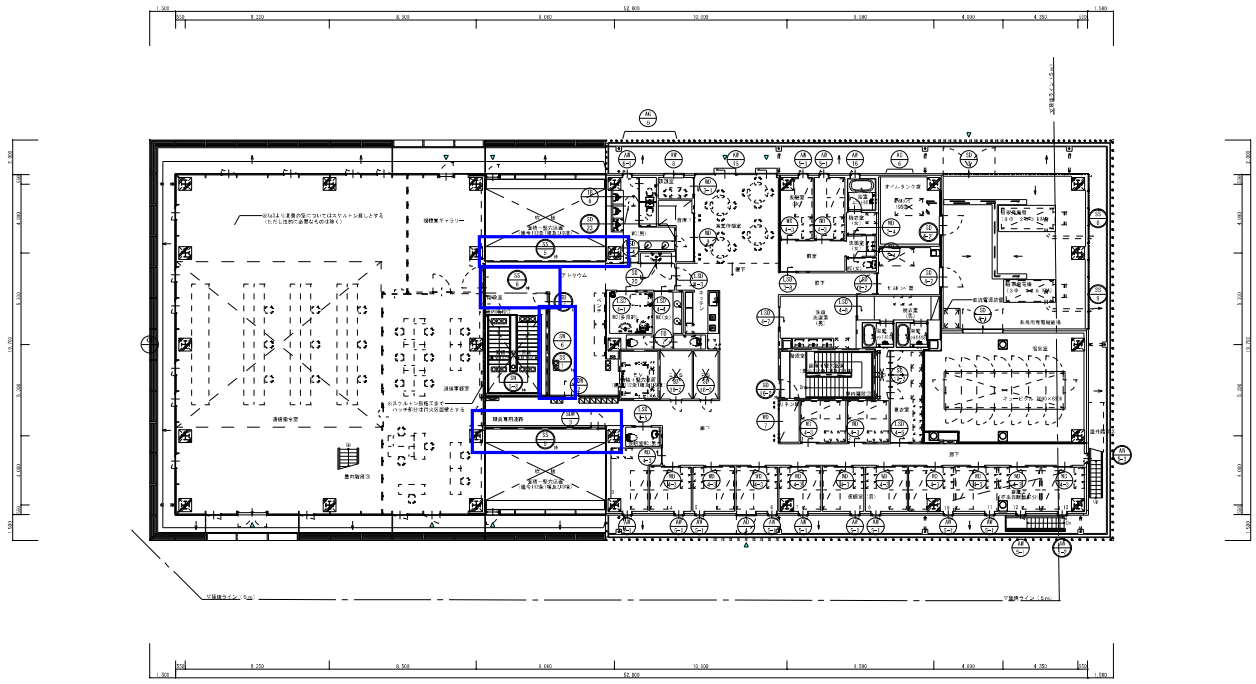[illegible]

別紙 (8/10)

[illegible]



中消防署 建具表

注 意 事 項		1階		2階		
